


1 LOCATION OF WATER WELL: Fraction SW 1/4 SW 1/4 SW 1/4 Section Number 31 Township Number T 14 S Range Number R 21 (E/W)  
 County: TREGO

Distance and direction from nearest town or city street address of well if located within city?  
14 miles South + 3/4 miles East of O'Gallah Ks 62656

2 WATER WELL OWNER: Cedar Bluff Cattle Feeders  
 RR#, St. Address, Box #: RR 2 Board of Agriculture, Division of Water Resources  
 City, State, ZIP Code: Ellis Ks 62622 Application Number:

3 LOCATE WELL'S LOCATION WITH AN "X" IN SECTION BOX:

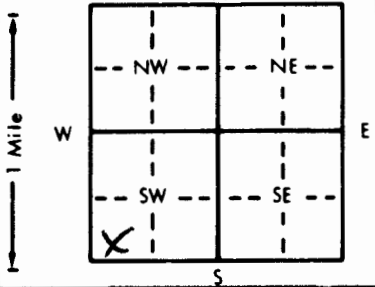

4 DEPTH OF COMPLETED WELL: 20 ft. ELEVATION:

Depth(s) Groundwater Encountered 1. 12 ft. 2. ft. 3. ft.  
 WELL'S STATIC WATER LEVEL: 12 ft. below land surface measured on mo/day/yr 5-4-91  
 Pump test data: Well water was 8 ft. after 1 1/2 hours pumping 18 gpm  
 Est. Yield 20 gpm: Well water was ft. after hours pumping gpm  
 Bore Hole Diameter: 10 in. to ft., and in. to ft.

WELL WATER TO BE USED AS:  
 5 Public water supply 8 Air conditioning 11 Injection well  
 1 Domestic 3 Feedlot 6 Oil field water supply 9 Dewatering 12 Other (Specify below)  
 2 Irrigation 4 Industrial 7 Lawn and garden only 10 Monitoring well

Was a chemical/bacteriological sample submitted to Department? Yes  No  If yes, mo/day/yr sample was submitted

5 TYPE OF BLANK CASING USED:  
 1 Steel 3 RMP (SR) 5 Wrought iron 8 Concrete tile CASING JOINTS: Glued Clamped  
2 PVC 4 ABS 6 Asbestos-Cement 9 Other (specify below) Welded  
 7 Fiberglass Threaded

Blank casing diameter: 5 in. to ft., Dia. in. to ft., Dia. in. to ft.  
 Casing height above land surface: 20 in., weight lbs./ft. Wall thickness or gauge No. SDR-21

TYPE OF SCREEN OR PERFORATION MATERIAL:  
 1 Steel 3 Stainless steel 5 Fiberglass 7 PVC 10 Asbestos-cement  
 2 Brass 4 Galvanized steel 6 Concrete tile 9 ABS 11 Other (specify)

SCREEN OR PERFORATION OPENINGS ARE:  
 1 Continuous slot 2 3 Mill slot 5 Gauzed wrapped 8 Saw cut 11 None (open hole)  
 2 Louvered shutter 4 Key punched 6 Wire wrapped 9 Drilled holes  
 7 Torch cut 10 Other (specify)

SCREEN-PERFORATED INTERVALS: From 0 ft. to 20 ft., From ft. to ft.  
 GRAVEL PACK INTERVALS: From 10 ft. to 20 ft., From ft. to ft.  
 From ft. to ft., From ft. to ft.

6 GROUT MATERIAL: 1 Neat cement 2 Cement grout 3 Bentonite 4 Other  
 Grout intervals: From 3 ft. to 10 ft., From ft. to ft., From ft. to ft.

What is the nearest source of possible contamination:  
 1 Septic tank 4 Lateral lines 7 Pit privy 10 Livestock pens 14 Abandoned water well  
 2 Sewer lines 5 Cess pool 8 Sewage lagoon 11 Fuel storage 15 Oil well/Gas well  
 3 Watertight sewer lines 6 Seepage pit 9 Feedyard 12 Fertilizer storage 16 Other (specify below)  
 13 Insecticide storage

Direction from well? East How many feet? 60

FROM	TO	LITHOLOGIC LOG	FROM	TO	PLUGGING INTERVALS
0	10	Top soil			
10	18	fine to med grey d Red gravel & sand			
18	20	shale			

7 CONTRACTOR'S OR LANDOWNER'S CERTIFICATION: This water well was (1) constructed, (2) reconstructed, or (3) plugged under my jurisdiction and was completed on (mo/day/year) 5-4-91 and this record is true to the best of my knowledge and belief. Kansas Water Well Contractor's License No. 206 This Water Well Record was completed on (mo/day/yr) 5-4-91 under the business name of huen Water Well Drilling by (signature) John Huen

OFFICE USE ONLY