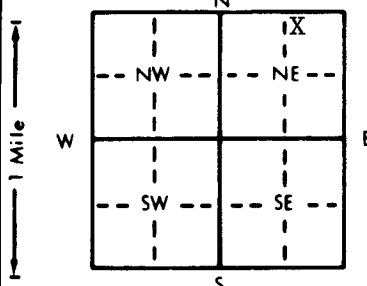


1 LOCATION OF WATER WELL: Fraction NW 1/4 NE 1/4 NE 1/4 Section Number 33 Township Number T 14 S Range Number R 22W EW
 County: Trego

Distance and direction from nearest town or city street address of well if located within city?
 13 S, 2 E of Wakeeny, Kansas

2 WATER WELL OWNER: Cedar Bluff Christian Camp
 RR#, St. Address, Box # : c/o Mae Hullet Board of Agriculture, Division of Water Resources
 City, State, ZIP Code : Box 216, Oakley, Kansas 67748 Application Number:

3 LOCATE WELL'S LOCATION WITH AN "X" IN SECTION BOX:

 4 DEPTH OF COMPLETED WELL: 521 ft. ELEVATION: Unknown
 Depth(s) Groundwater Encountered 1. 180 ft. 2. ft. 3. ft.
 WELL'S STATIC WATER LEVEL: 180 ft. below land surface measured on mo/day/yr 6/23/95
 Pump test data: Well water was ft. after hours pumping gpm
 Est. Yield 30 gpm: Well water was ft. after hours pumping gpm
 Bore Hole Diameter 8 3/4 in. to 521 ft., and in. to ft.
 WELL WATER TO BE USED AS:
 1 Domestic 3 Feedlot 6 Oil field water supply 9 Dewatering 12 Other (Specify below)
 2 Irrigation 4 Industrial 7 Lawn and garden only 10 Monitoring well
 Was a chemical/bacteriological sample submitted to Department? Yes No: If yes, mo/day/yr sample was submitted
 Water Well Disinfected? Yes No

5 TYPE OF BLANK CASING USED:
 1 Steel 3 RMP (SR) 5 Wrought iron 8 Concrete tile CASING JOINTS: Glued Clamped
 2 PVC 4 ABS 6 Asbestos-Cement 9 Other (specify below) Welded
 7 Fiberglass Threaded
 Blank casing diameter 5 in. to 461 ft., Dia 46 in. to ft., Dia in. to ft. SDR 17.261' to 521'
 Casing height above land surface 12 in., weight 2.85 lbs./ft. Wall thickness or gauge No. SDR 21.0' to 261'
 TYPE OF SCREEN OR PERFORATION MATERIAL:
 1 Steel 3 Stainless steel 5 Fiberglass 7 PVC 10 Asbestos-cement
 2 Brass 4 Galvanized steel 6 Concrete tile 8 RMP (SR) 11 Other (specify)
 9 ABS 12 None used (open hole)
 SCREEN OR PERFORATION OPENINGS ARE:
 1 Continuous slot 3 Mill slot 5 Gauzed wrapped 8 Saw cut 11 None (open hole)
 2 Louvered shutter 4 Key punched 6 Wire wrapped 9 Drilled holes
 7 Torch cut 10 Other (specify)
 SCREEN-PERFORATED INTERVALS: From 461 ft. to 521 ft., From ft. to ft.
 GRAVEL PACK INTERVALS: From 24 ft. to 98 ft., From 100 ft. to 521 ft.

6 GROUT MATERIAL: 1 Neat cement 2 Cement grout 3 Bentonite 4 Other
 Grout Intervals: From 3 ft. to 24 ft., From 98 ft. to 100 ft., From ft. to ft.
 What is the nearest source of possible contamination:
 1 Septic tank 4 Lateral lines 7 Pit privy 10 Livestock pens 14 Abandoned water well
 2 Sewer lines 5 Cess pool 8 Sewage lagoon 11 Fuel storage 15 Oil well/Gas well
 3 Watertight sewer lines 6 Seepage pit 9 Feedyard 12 Fertilizer storage 16 Other (specify below)
 13 Insecticide storage None on Hillside

Direction from well? How many feet?

FROM	TO	LITHOLOGIC LOG	FROM	TO	PLUGGING INTERVALS
0	6	Top soil and clay			
6	10	Limestone			
10	360	Black shale			
360	461	Blue shale			
461	521	Sand rock			

7 CONTRACTOR'S OR LANDOWNER'S CERTIFICATION: This water well was (1) constructed, (2) reconstructed, or (3) plugged under my jurisdiction and was completed on (mo/day/year) 6/23/95 and this record is true to the best of my knowledge and belief. Kansas Water Well Contractor's License No. 186 This Water Well Record was completed on (mo/day/yr) 6/24/95 under the business name of Kelly's Water Well Service, Inc. by (signature) *Oliver Good*

OFFICE USE ONLY
T
R
EW
SEC.