


1 LOCATION OF WATER WELL: Fraction SE 1/4 NE 1/4 NW 1/4 Section Number 33 Township Number 17 Range Number 22 E/W (W)
 County: Trego

Distance and direction from nearest town or city street address of well if located within city?

Intersection of 310th Ave & W Road 1/2 mile east 1 mile south

2 WATER WELL OWNER: North Shore Cabin Area Global Positioning Systems (decimal degrees, min. of 4 digits)
 RR#, St. Address, Box #: P.O 797 Latitude: _____
 City, State ZIP Code: HAYS, KS 67601 Longitude: _____
 Elevation: _____
 Datum: _____
 Data Collection Method: _____

3 MARK WELL'S LOCATION WITH AN "X" IN SECTION BOX:

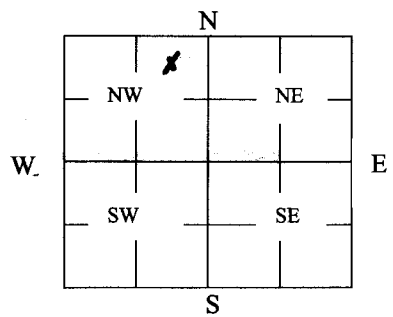

4 DEPTH OF WELL 590 ft.

WELL'S STATIC WATER LEVEL 165 ft

WELL WAS USED AS:

- | | | |
|--------------|----------------------------|-------------------|
| 1 Domestic | 5 Public Water Supply | 9 Dewatering |
| 2 Irrigation | 6 Oil Field Water Supply | 10 Monitoring |
| 3 Feedlot | 7 Domestic (Lawn & Garden) | 11 Injection Well |
| 4 Industrial | 8 Air Conditioning | 12 Other _____ |

Was a chemical/bacteriological sample submitted to Department? Yes _____ No X

5 TYPE OF BLANK CASING USED:

- | | | | | |
|--------------|------------|-------------------|-----------------|-------------------------|
| 1 Steel | 3 RMP (SR) | 5 Wrought | 7 Fiberglass | 9 Other (Specify below) |
| <u>2 PVC</u> | 4 ABS | 6 Asbestos-Cement | 8 Concrete Tile | _____ |

Blank casing diameter 5 in. Was casing pulled? Yes _____ No X If yes, how much _____
 Casing height above or below land surface 60 in.

6 GROUT PLUG MATERIAL: 1 Neat cement 2 Cement grout 3 Bentonite 4 Other _____

Grout Plug Intervals: From 167 ft. to 162 ft., From 24 ft. to 5 ft., From _____ to _____ ft.

What is the nearest source of possible contamination:

- | | | | |
|--------------------------|-------------------|-------------------------|----------------------------|
| 1 Septic tank | 6 Seepage pit | 11 Fuel Storage | 16 Other (specify below) |
| 2 Sewer lines | 7 Pit privy | 12 Fertilizer storage | _____ |
| 3 Watertight sewer lines | 8 Sewage lagoon | 13 Insecticide storage | _____ |
| 4 Lateral lines | 9 Feedyard | 14 Abandoned water well | Direction from well? _____ |
| 5 Cess pool | 10 Livestock pens | 15 Oil well/Gas well | How many feet? _____ |

FROM	TO	PLUGGING MATERIALS	FROM	TO	PLUGGING MATERIALS
<u>590</u>	<u>165</u>	<u>Gravel</u>			<u>Site ID</u>
<u>165</u>	<u>160</u>	<u>Bentonite</u>			<u>00041339</u>
<u>160</u>	<u>24</u>	<u>CLAY</u>			
<u>24</u>	<u>5</u>	<u>Bentonite</u>			
<u>5</u>	<u>0</u>	<u>CLAY</u>			

7 CONTRACTOR'S OR LANDOWNER'S CERTIFICATION: This water well was plugged under my jurisdiction and was completed on (mo/day/year) 4-23-12 and this record is true to the best of my knowledge and belief. Kansas Water Well Contractor's License No. 626. This Water Well Record was completed on (mo/day/year) 5-10-12 under the business name of Town & Country Water Well by (signature) al Treg

INSTRUCTIONS: Use typewriter or ballpoint pen. Please press firmly and print clearly. Please fill in blanks, underline or circle the correct answers. Send top three copies to Kansas Department of Health and Environment, Bureau of Water, Geology Section, 1000 SW Jackson St., Ste. 420, Topeka, Kansas 66612-1367. Telephone: 785/296-5522. Send one to Water Well Owner and retain one for your records. Visit us at <http://www.kdheks.gov/geo/waterwells>.