


1 LOCATION OF WATER WELL: County: Trego Fraction: NE 1/4 NE 1/4 SW 1/4 Section Number: 10 Township Number: T 14 S Range Number: R 22 EW

Distance and direction from nearest town or city street address of well if located within city?  
0.5 mi + 1/2 mi N. on rd. south of Ogallah Kansas

2 WATER WELL OWNER: Albert Flop Board of Agriculture, Division of Water Resources  
 RR#, St. Address, Box #: R R Ogallah Kansas Application Number:

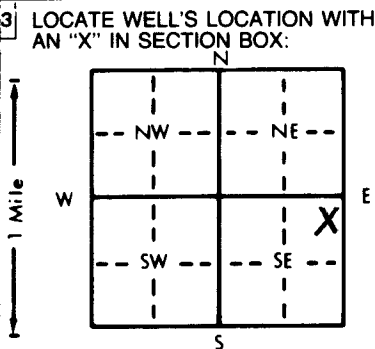

4 DEPTH OF COMPLETED WELL: 75 ft. ELEVATION: .....  
 Depth(s) Groundwater Encountered 1. 60 ft. 2. .... ft. 3. .... ft.  
 WELL'S STATIC WATER LEVEL: 60 ft. below land surface measured on mo/day/yr May 27-93  
 Pump test data: Well water was ..... ft. after ..... hours pumping ..... gpm  
 Est. Yield 5 gpm: Well water was ..... ft. after ..... hours pumping ..... gpm  
 Bore Hole Diameter: 10 in. to 75 ft., and ..... in. to ..... ft.  
 WELL WATER TO BE USED AS:  
 1 Domestic     3 Feedlot     6 Oil field water supply     9 Dewatering     12 Other (Specify below)  
 2 Irrigation     4 Industrial     7 Lawn and garden only     10 Monitoring well  
 Was a chemical/bacteriological sample submitted to Department? Yes..... No.....; If yes, mo/day/yr sample was submitted  
 Water Well Disinfected? Yes..... No.....

5 TYPE OF BLANK CASING USED:  
 1 Steel     3 RMP (SR)     6 Asbestos-Cement     9 Other (specify below)     Welded  
 2 PVC     4 ABS     7 Fiberglass    .....     Threaded  
 Blank casing diameter: 3 in. to 55 ft., Dia. .... in. to ..... ft., Dia. .... in. to ..... ft.  
 Casing height above land surface: 20 in., weight 160 lbs./ft. Wall thickness or gauge No. ....  
 TYPE OF SCREEN OR PERFORATION MATERIAL:  
 1 Steel     3 Stainless steel     5 Fiberglass     7 PVC     10 Asbestos-cement  
 2 Brass     4 Galvanized steel     6 Concrete tile     8 RMP (SR)     11 Other (specify) .....  
 12 None used (open hole)  
 SCREEN OR PERFORATION OPENINGS ARE:  
 1 Continuous slot     3 Mill slot     5 Gauzed wrapped     8 Saw cut     11 None (open hole)  
 2 Louvered shutter     4 Key punched     6 Wire wrapped     9 Drilled holes  
 7 Torch cut     10 Other (specify) .....  
 SCREEN-PERFORATED INTERVALS: From 55 ft. to 75 ft., From ..... ft. to ..... ft.  
 GRAVEL PACK INTERVALS: From 55 ft. to 75 ft., From ..... ft. to ..... ft.

6 GROUT MATERIAL: 1 Neat cement    2 Cement grout     3 Bentonite    4 Other .....  
 Grout Intervals: From 30 ft. to 40 ft., From 20 ft. to 0 ft., From ..... ft. to ..... ft.  
 What is the nearest source of possible contamination:  
 1 Septic tank     4 Lateral lines     7 Pit privy     10 Livestock pens     14 Abandoned water well  
 2 Sewer lines     5 Cess pool     8 Sewage lagoon     11 Fuel storage     15 Oil well/Gas well  
 3 Watertight sewer lines     6 Seepage pit     9 Feedyard     12 Fertilizer storage     16 Other (specify below)  
 13 Insecticide storage    None  
 Direction from well? How many feet?

FROM	TO	LITHOLOGIC LOG	FROM	TO	PLUGGING INTERVALS
0	15	Surface Clay			
15	35	Hard yellow clay			
35	45	Yellow rock			
45	57	Grey shale			

7 CONTRACTOR'S OR LANDOWNER'S CERTIFICATION: This water well was (1) constructed, (2) reconstructed, or (3) plugged under my jurisdiction and was completed on (mo/day/year) May 27-93 and this record is true to the best of my knowledge and belief. Kansas Water Well Contractor's License No. 444 This Water Well Record was completed on (mo/day/yr) May 27-93 under the business name of Andruson Drilling by (signature) Andy Andruson

OFFICE USE ONLY  
T  
R  
EW  
SEC.  
1/4  
1/4  
1/4