

WATER WELL PLUGGING RECORD Form WWC-5P

KSA 82a-1212

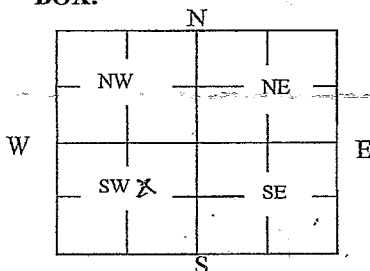
ID NO.

1 LOCATION OF WATER WELL: County: TREGO	Fraction NW 1/4 SW 1/4 NE 1/4 SW 1/4	Section Number 6	Township Number T 14 S	Range Number 23 <input type="checkbox"/> E <input checked="" type="checkbox"/> W
--	--	----------------------------	----------------------------------	--

 Street/Rural Address of Well Location; if unknown, distance & direction from nearest town or intersection: If at owner's address, check here ☐ **23033 T RD**
WAKEENEY, KS 67672
Global Positioning Systems (GPS) information:

 Latitude: **38.860827** (in decimal degrees)
 Longitude: **-99.723592** (in decimal degrees)
 Elevation: **2342**
 Horizontal Datum: ☐ WGS84, ☐ NAD83, ☐ NAD27
 Collection Method:

2 WATER WELL OWNER: KAY LINDEN
 RR#, St. Address, Box #: **1173 NE 10TH RD**
 City, State ZIP Code: **ELLINWOOD, KS 67526**
☐ GPS unit (Make/Model: _____)
☒ Digital Map/Photo, ☐ Topographic Map, ☐ Land Survey
 Est. Accuracy: ☐ <3 m, ☒ 3-5 m, ☐ 5-15 m, ☐ >15 m

3 MARK WELL'S LOCATION WITH AN "X" IN SECTION BOX:

4 DEPTH OF WELL 11'6" ft. well 1 of 4

 WELL'S STATIC WATER LEVEL 4 ft

WELL WAS USED AS:

- | | | |
|-------------------------------------|---|---|
| <input type="checkbox"/> Domestic | <input type="checkbox"/> Public Water Supply | <input type="checkbox"/> Dewatering |
| <input type="checkbox"/> Irrigation | <input type="checkbox"/> Oil Field Water Supply | <input type="checkbox"/> Monitoring |
| <input type="checkbox"/> Feedlot | <input type="checkbox"/> Domestic (Lawn & Garden) | <input type="checkbox"/> Injection Well |
| <input type="checkbox"/> Industrial | <input type="checkbox"/> Air Conditioning | <input type="checkbox"/> Other _____ |

 Was a chemical/bacteriological sample submitted to Department? Yes ☐ No ☒
5 TYPE OF BLANK CASING USED:

- ☒
- Steel
- ☐
- RMP (SR)
- ☐
- Wrought
- ☐
- Fiberglass
- ☐
- Other (Specify below)
-
- ☐
- PVC
- ☐
- ABS
- ☐
- Asbestos-Cement
- ☐
- Concrete Tile

 Blank casing diameter 16 in. Was casing pulled? Yes ☐ No ☒ If yes, how much _____
 Casing height above or below land surface 1 in.

6 GROUT PLUG MATERIAL: ☒ Neat cement ☐ Cement grout ☒ Bentonite ☐ Other _____

 Grout Plug Intervals: From 0 ft. to 2'6" ft., From 2'6" ft. to 3'6" ft., From _____ ft. to _____ ft.

What is the nearest source of possible contamination:

- | | | | |
|---|---|---|--|
| <input type="checkbox"/> Septic tank | <input type="checkbox"/> Seepage pit | <input type="checkbox"/> Fuel storage | <input type="checkbox"/> Other (specify below) |
| <input type="checkbox"/> Sewer lines | <input type="checkbox"/> Pit privy | <input type="checkbox"/> Fertilizer storage | |
| <input type="checkbox"/> Watertight sewer lines | <input type="checkbox"/> Sewage lagoon | <input type="checkbox"/> Insecticide storage | |
| <input type="checkbox"/> Lateral lines | <input type="checkbox"/> Feedyard | <input type="checkbox"/> Abandoned water well | Direction from well? _____ |
| <input type="checkbox"/> Cess pool | <input type="checkbox"/> Livestock pens | <input type="checkbox"/> Oil well/Gas well | How many feet? _____ |

FROM	TO	PLUGGING MATERIALS	FROM	TO	PLUGGING MATERIALS
<u>11'6"</u>	<u>3'6"</u>	<u>BLEACH/SAND</u>			
<u>3'6"</u>	<u>2'6"</u>	<u>BENTONITE</u>			
<u>2'6"</u>	<u>0"</u>	<u>CEMENT</u>			

7 CONTRACTOR'S OR LANDOWNER'S CERTIFICATION: This water well was plugged under my jurisdiction and was completed on (mo/day/year) 06/18/2020 and this record is true to the best of my knowledge and belief. Kansas Water Well Contractor's License No. SC153. This Water Well Record was completed on (mo/day/year) 06/22/2020 under the business name of FLAX DITCHING & PUMP, LLC by (signature) [Signature]

Send one white copy to Kansas Department of Health & Environment, Geology Section, 1000 SW Jackson Street, Ste. 420, Topeka, KS 66612-1367. Send one copy to WATER WELL OWNER and retain one for your records.

 Visit us at <http://www.kdheks.gov/waterwell/index.html> Telephone 785-296-5524.

KSA82a-1212

Revised 1/20/2015