

County: Trego Fraction NE NE SE Sec. 5 T 14 S R 25 (EW)

CORRECTION(S) TO WATER WELL COMPLETION RECORD (WWC-5)
(to rectify lacking or incorrect information)

Owner: Ted Walt

Location was listed as:

Section-Township-Range: 5-14S-29

Fraction (1/4 1/4 1/4): NE NE SE

Location changed to:

5-14S-25W

NE NE SE

Other changes: Initial statements: _____

Changed to: _____

Comments: _____

Verification method: written & legal descriptions, county ownership map, and mapping tool & aerial photos on KGS website.

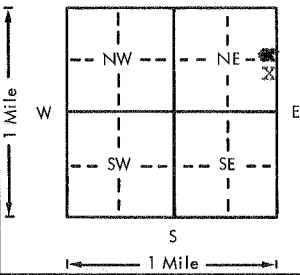
initials: DRd date: 7/2/2013

Submitted by: Kansas Geological Survey, Data Resources Library, 1930 Constant Ave., Lawrence, KS 66047-3726
to: Kansas Dept of Health & Environment, Bureau of Water, 1000 SW Jackson, Suite 420, Topeka, KS 66612-1367.

USE TYPEWRITER OR BALL POINT PEN-PRESS FIRMLY, PRINT CLEARLY.

WATER WELL RECORD
KSA 82a-1201-1215

Kansas Department of Health and Environment-Division of Environment (Water well Contractors)
Topeka, Kansas 66620

1. Location of well:	County Trego	Fraction NE 1/4 NE 1/4 SE 1/4	Section number 5	Township number T 14 S R 29 E/W	Range number
2. Distance and direction from nearest town or city: 12 south of Collyer			3. Owner of well: Ted Walt R.R. or street: Collyer, Ks. 67631 City, state, zip code:		
4. Locate with "X" in section below: N W E S 1 Mile			Sketch map: 		
5. Type and color of material			From	To	6. Bore hole dia. <u>8</u> in. Completion date _____ Well depth <u>26</u> ft. <u>5/15/78</u>
clay and silt			0	15	7. <input type="checkbox"/> Cable tool <input checked="" type="checkbox"/> Rotary <input type="checkbox"/> Driven <input type="checkbox"/> Dug <input type="checkbox"/> Hollow rod <input type="checkbox"/> Jetted <input type="checkbox"/> Bored <input type="checkbox"/> Reverse rotary
mud and clay			15	24	8. Use: <input type="checkbox"/> Domestic <input type="checkbox"/> Public supply <input type="checkbox"/> Industry <input type="checkbox"/> Irrigation <input type="checkbox"/> Air conditioning <input checked="" type="checkbox"/> Stock <input type="checkbox"/> Lawn <input type="checkbox"/> Oil field water <input type="checkbox"/> Other
sand			24	26	9. Casing: Material _____ Height: <u>Above</u> or below Threaded _____ Welded _____ Surface <u>12</u> in. RMP _____ PVC <input checked="" type="checkbox"/> Weight _____ lbs./ft. Dia. <u>5</u> in. to <u>26</u> ft. depth; Wall Thickness: inches or Dia. _____ in. to _____ ft. depth; gage No. <u>250</u>
					10. Screen: Manufacturer's name <u>Peerless Plastics</u> Type <u>pvc</u> Dia. <u>5 in.</u> Slot/gauze <u>1/16</u> Length <u>10 ft.</u> Set between <u>16</u> ft. and <u>26</u> ft. _____ ft. and _____ ft. Gravel pack? <input checked="" type="checkbox"/> Size range of material <u>1/2 down</u>
					11. Static water level: _____ mo./day/yr. <u>16</u> ft. below land surface Date <u>5/15/78</u>
					12. Pumping level below land surfaces: _____ ft. after _____ hrs. pumping _____ g.p.m. _____ ft. after _____ hrs. pumping _____ g.p.m. Estimated maximum yield _____ g.p.m.
					13. Water sample submitted: _____ mo./day/yr. <input type="checkbox"/> Yes <input checked="" type="checkbox"/> No Date _____
					14. Well head completion: <input type="checkbox"/> Pitless adapter _____ inches above grade
					15. Well grouted? <input checked="" type="checkbox"/> With: <u>clay</u> cement _____ Bentonite _____ Concrete _____ Depth: From <u>0</u> ft. to <u>5</u> ft.
					16. Nearest source of possible contamination: ft. _____ Direction _____ Type _____ Well disinfected upon completion? <input type="checkbox"/> Yes <input checked="" type="checkbox"/> No
					17. Pump: <input checked="" type="checkbox"/> Not installed Manufacturer's name _____ Model number _____ HP _____ Volts _____ Length of drop pipe _____ ft. capacity _____ g.p.m. Type: <input type="checkbox"/> Submersible <input type="checkbox"/> Turbine <input type="checkbox"/> Jet <input type="checkbox"/> Reciprocating <input type="checkbox"/> Centrifugal <input type="checkbox"/> Other
(Use a second sheet if needed)					
18. Elevation: Topography: <input type="checkbox"/> Hill <input type="checkbox"/> Slope <input checked="" type="checkbox"/> Upland <input type="checkbox"/> Valley		19. Remarks:		20. Water well contractor's certification: This well was drilled under my jurisdiction and this report is true to the best of my knowledge and belief. <u>Aqua Well Drilling</u> <u>281</u> Business name License No. Address <u>Collyer, Ks. 67730</u> Signed <u>J M Justice</u> Date <u>6-78</u> Authorized representative	