


OFFICE USE ONLY

1 LOCATION OF WATER WELL: County: **Gove** Fraction: **SW 1/4 SW 1/4 NE 1/4** Section Number: **9** Township Number: **T 14 S** Range Number: **R 28 EW**

Distance and direction from nearest town or city street address of well if located within city?

2 WATER WELL OWNER: **Richard Tustin**
 RR#, St. Address, Box #: **5071 Co. Rd M**
 City, State, ZIP Code: **Gove, Ks 67736**
 Board of Agriculture, Division of Water Resources
 Application Number:

3 LOCATE WELL'S LOCATION WITH AN "X" IN SECTION BOX:

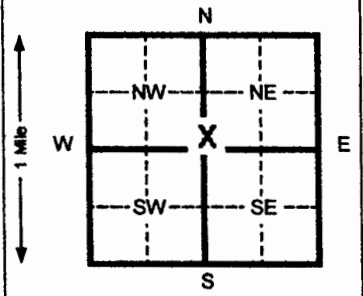

4 DEPTH OF COMPLETED WELL: **30** ft. ELEVATION: _____

Depth(s) Groundwater Encountered 1 _____ ft. 2 _____ ft. 3 _____ ft.

WELL'S STATIC WATER LEVEL: **na** ft. below land surface measured on mo/day/yr

Pump test data: Well water was _____ ft. after _____ hours pumping _____ gpm

Est. Yield _____ gpm: Well water was _____ ft. after _____ hours pumping _____ gpm

Bore Hole Diameter: **8** in. to **30** ft. and _____ in. to _____ ft.

WELL WATER TO BE USED AS:

5 Public water supply	8 Air conditioning	11 Injection well
<input checked="" type="checkbox"/> 1 Domestic	3 Feed lot	6 Oil field water supply
9 Dewatering	12 Other (Specify below)	
2 Irrigation	4 Industrial	7 Lawn and garden (domestic)
10 Monitoring well		

Was a chemical/bacteriological sample submitted to Department? Yes _____ No If yes, mo/day/yr sample was submitted _____

Water Well Disinfected? Yes No _____

5 TYPE OF BLANK CASING USED:

1 Steel	3 RMP (SR)	5 Wrought Iron	8 Concrete tile	CASING JOINTS: Glued <input checked="" type="checkbox"/> Clamped _____
<input checked="" type="checkbox"/> 2 PVC	4 ABS	6 Asbestos-Cement	9 Other (specify below)	Welded _____
		7 Fiberglass		Threaded _____

Blank casing diameter: **4.5** in. to **15** ft., Dia _____ in. to _____ ft., Dia _____ in. to _____ ft.

Casing height above land surface: **18** in., weight **2.38** lbs./ft. Wall thickness or gauge No. **248**

TYPE OF SCREEN OR PERFORATION MATERIAL:

1 Steel	3 Stainless steel	5 Fiberglass	8 RMP (SR)	10 Asbestos-cement
2 Brass	4 Galvanized steel	6 Concrete tile	9 ABS	11 Other (specify)
				12 None used (open hole)

SCREEN OR PERFORATION OPENINGS ARE:

1 Continuous slot	3 Mill slot	5 Gauzed wrapped	<input checked="" type="checkbox"/> 8 Saw cut	11 None (open hole)
2 Louvered shutter	4 Key punched	6 Wire wrapped	9 Drilled holes	
		7 Torch cut	10 Other (specify)	

SCREEN-PERFORATED INTERVALS: From **15** ft. to **30** ft. From _____ ft. to _____ ft.

GRAVEL PACK INTERVALS: From **6** ft. to **30** ft. From _____ ft. to _____ ft.

6 GROUT MATERIAL: 1 Neat cement 2 Cement grout 3 Bentonite 4 Other _____

Grout intervals From **0** ft. to **6** ft. From _____ ft. to _____ ft. From _____ ft. to _____ ft.

What is the nearest source of possible contamination:

1 Septic tank	4 Lateral lines	7 Pit privy	10 Livestock pens	14 Abandoned water well
2 Sewer lines	5 Cess pool	8 Sewage lagoon	11 Fuel storage	15 Oil well/ Gas well
3 Watertight sewer lines	6 Seepage pit	9 Feedyard	12 Fertilizer storage	16 Other (specify below)
			13 Insecticide storage	none

Direction from well? _____ How many feet? _____

FROM	TO	CODE	LITHOLOGIC LOG	FROM	TO	PLUGGING INTERVALS
0	2		Surface			
2	4		Loess			
4	10		Clay w/sand strks			
10	14		Med sand w/gravel			
14	30		Yellow ochre w/gray shale			

7 CONTRACTOR'S OR LANDOWNER'S CERTIFICATION: This water well was (1) constructed, (2) reconstructed, or (3) plugged under my jurisdiction and was completed on (mo/day/yr) **6-27-06** and this record is true to the best of my knowledge and belief. Kansas Water Well Contractor's License No. **554** This Water Well Record was completed on (mo/day/yr) **7-7-06** under the business name of **Woofler Pump & Well Inc.** by (signature) *Jay C. Woofler*

SEC