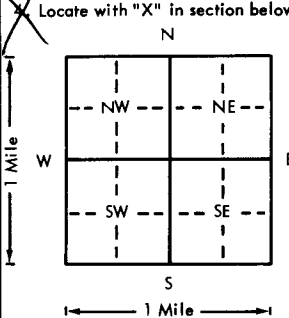


USE TYPEWRITER OR BALL POINT PEN-PRESS FIRMLY, PRINT CLEARLY.

WATER WELL RECORD  
KSA 82a-1201-1215

Kansas Department of Health and Environment-Division of Environment  
(Water well Contractors)  
Topeka, Kansas 66620

1. Location of well:	County <b>Gove</b>	Fraction <b>1/4 1/4 NW 1/4</b>	Section number <b>27</b>	Township number <b>T 14 S</b>	Range number <b>R 29</b>
2. Distance and direction from nearest town or city: Street address of well location if in city:		<b>11 S &amp; 3 W of Gove</b>		3. Owner of well: <b>Harold Lundgren</b> R.R. or street: <b>Gove, Ks. 67736</b> City, state, zip code:	
<input checked="" type="checkbox"/> Locate with "X" in section below: 		Sketch map:		6. Bore hole dia. <u>8</u> in. Completion date _____ Well depth <u>50</u> ft. <u>7/2/77</u>	
5. Type and color of material		From	To	7. <input type="checkbox"/> Cable tool <input checked="" type="checkbox"/> Rotary <input type="checkbox"/> Driven <input type="checkbox"/> Dug <input type="checkbox"/> Hollow rod <input type="checkbox"/> Jetted <input type="checkbox"/> Bored <input type="checkbox"/> Reverse rotary	
yellow clay		0	15	8. Use: <input checked="" type="checkbox"/> Domestic <input type="checkbox"/> Public supply <input type="checkbox"/> Industry <input type="checkbox"/> Irrigation <input type="checkbox"/> Air conditioning <input type="checkbox"/> Stock <input type="checkbox"/> Lawn <input type="checkbox"/> Oil field water <input type="checkbox"/> Other	
fine sand		15	30	9. Casing: Material <u>pvc</u> Height <u>Above</u> or below Threaded _____ Welded <u>51</u> Surface <u>12</u> in. RMP _____ PVC <input checked="" type="checkbox"/> Weight _____ lbs./ft. Dia. <u>5</u> in. to <u>50</u> ft. depth Wall Thickness: inches or Dia. _____ in. to _____ ft. depth gage No. <u>250</u>	
clay		30	32	10. Screen: Manufacturer's name _____ <u>Valley Steel</u> Type <u>PVC</u> Dia. <u>5 in</u> Slot/gauze <u>1/16</u> Length <u>10 ft.</u> Set between <u>40</u> ft. and <u>50</u> ft. _____ ft. and _____ ft. Gravel pack? <input checked="" type="checkbox"/> Size range of material. <u>1/4</u> down	
sand		32	43	11. Static water level: _____ mo./day/yr. <u>30</u> ft. below land surface Date <u>7/2/77</u>	
clay		43	45	12. Pumping level below land surfaces: _____ ft. after _____ hrs. pumping _____ g.p.m. _____ ft. after _____ hrs. pumping _____ g.p.m. Estimated maximum yield <u>10</u> g.p.m.	
<del>KS</del> sand		43	48	13. Water sample submitted: _____ mo./day/yr. <input type="checkbox"/> Yes <input checked="" type="checkbox"/> No Date _____	
shale		48	50	14. Well head completion: <input type="checkbox"/> Pitless adapter _____ Inches above grade <input checked="" type="checkbox"/> Well grouted? <input checked="" type="checkbox"/> With: <u>clay</u> cement _____ Bentonite _____ Concrete _____ Depth: From <u>0</u> ft. to <u>5</u> ft.	
				<input checked="" type="checkbox"/> Nearest source of possible contamination: ft. _____ Direction _____ Type _____ Well disinfected upon completion? <input checked="" type="checkbox"/> Yes <input type="checkbox"/> No	
				17. Pump: <input checked="" type="checkbox"/> Not installed Manufacturer's name _____ Model number _____ HP _____ Volts _____ Length of drop pipe _____ ft. capacity _____ g.p.m. Type: <input type="checkbox"/> Submersible <input type="checkbox"/> Turbine <input type="checkbox"/> Jet <input type="checkbox"/> Reciprocating <input type="checkbox"/> Centrifugal <input type="checkbox"/> Other	
				20. Water well contractor's certification: This well was drilled under my jurisdiction and this report is true to the best of my knowledge and belief. <u>Aqua Well Drilling 281</u> Business name _____ License No. _____ Address <u>Gove, Ks. 67736</u> Signed <u>M. Little</u> Date <u>7-10-77</u> Authorized representative	
18. Elevation:	19. Remarks:				
Topography: <input type="checkbox"/> Hill <input type="checkbox"/> Slope <input checked="" type="checkbox"/> Upland <input type="checkbox"/> Valley					

Forward the white, blue and pink copies to the Department of Health and Environment

Form WWC-5