MW-5

WATER WELL RECORD Form WWC-5 KSA 82a-1212

1 LOCATION OF WATER WELL: County: Saline | Fraction: NE ¼ NW ¼ SW ¼ | Section Number: 13 | Township Number: T 14 S | Range Number: R 3 (E) W

Distance and direction from nearest town or city street address of well if located within city?
443 S. Santa Fe, Salina, KS

2 WATER WELL OWNER:
RR#, St. Address, Box # City of Salina
City, State, ZIP Code 300 W. Ash, Salina, KS 67402
Board of Agriculture, Division of Water Resources
Application Number:

3 LOCATE WELL'S LOCATION WITH AN "X" IN SECTION BOX:

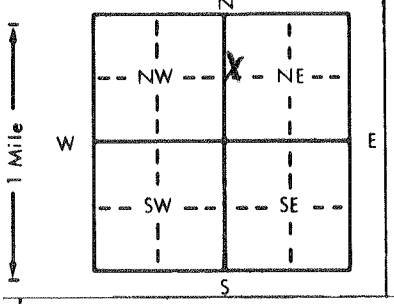

4 DEPTH OF COMPLETED WELL 42 ft. ELEVATION:
Depth(s) Groundwater Encountered 1. 33.6 ft. 2. ft. 3. ft.
WELL'S STATIC WATER LEVEL 32.25 ft. below land surface measured on mo/day/yr 9/13/95
Pump test data: Well water was ft. after hours pumping gpm
Est. Yield gpm: Well water was ft. after hours pumping gpm
Bore Hole Diameter 8.625 in. to 43 ft., and in. to ft.
WELL WATER TO BE USED AS: 1 Domestic 2 Irrigation 3 Feedlot 4 Industrial 5 Public water supply 6 Oil field water supply 7 Lawn and garden only 8 Air conditioning 9 Dewatering (10) Monitoring well 11 Injection well 12 Other (Specify below) MW-5
Was a chemical/bacteriological sample submitted to Department? Yes ___ No X; If yes, mo/day/yr sample was submitted
Water Well Disinfected? Yes ___ No X

5 TYPE OF BLANK CASING USED: (2) PVC 1 Steel 3 RMP (SR) 4 ABS 5 Wrought iron 6 Asbestos-Cement 7 Fiberglass 8 Concrete tile 9 Other (specify below)
CASING JOINTS: Glued ___ Clamped ___ Welded ___ Threaded X
Blank casing diameter 2 in. to 27 ft., Dia in. to ft., Dia in. to ft.
Casing height above land surface 0 in., weight SCH. 40 PVC lbs./ft. Wall thickness or gauge No.

TYPE OF SCREEN OR PERFORATION MATERIAL: (7) PVC 1 Steel 2 Brass 3 Stainless steel 4 Galvanized steel 5 Fiberglass 6 Concrete tile 8 RMP (SR) 9 ABS 10 Asbestos-cement 11 Other (specify) 12 None used (open hole)

SCREEN OR PERFORATION OPENINGS ARE: 1 Continuous slot (3) Mill slot 2 Louvered shutter 4 Key punched 5 Gauzed wrapped 6 Wire wrapped 7 Torch cut 8 Saw cut 9 Drilled holes 10 Other (specify) 11 None (open hole)

SCREEN-PERFORATED INTERVALS: From 27 ft. to 42 ft., From ___ ft. to ___ ft.
SAND From ___ ft. to ___ ft., From ___ ft. to ___ ft.
~~GRAVEL~~ PACK INTERVALS: From 26 ft. to 43 ft., From ___ ft. to ___ ft.
From ___ ft. to ___ ft., From ___ ft. to ___ ft.

6 GROUT MATERIAL: 2 1 Neat cement (2) Cement grout (3) Bentonite 4 Other
Grout Intervals: From 0 ft. to 24 ft., From 24 ft. to 26 ft., From ___ ft. to ___ ft.

What is the nearest source of possible contamination:
1 Septic tank 2 Sewer lines 3 Watertight sewer lines 4 Lateral lines 5 Cess pool 6 Seepage pit 7 Pit privy 8 Sewage lagoon 9 Feedyard 10 Livestock pens 11 Fuel storage 12 Fertilizer storage 13 Insecticide storage (16) Other (specify below) Contaminated Site
Direction from well? How many feet?

FROM	TO	LITHOLOGIC LOG
GL	2.00	Fill Material
2.00	16.25	Silty Clay (CL)
16.25	33.50	Clayey Silt (ML)
33.50	43.00	Sand (SP)
43.00	TD	End of Borehole

PLUGGING INTERVALS:
Flush Mount
waiver
D. Taylor
8/21/95

7 CONTRACTOR'S OR LANDOWNER'S CERTIFICATION: This water well was (1) constructed, (2) reconstructed, or (3) plugged under my jurisdiction and was completed on (mo/day/year) 8/30/95 and this record is true to the best of my knowledge and belief. Kansas Water Well Contractor's License No. 585 This Water Well Record was completed on (mo/day/yr) 9/18/95 under the business name of Associated Environmental, Inc. by (signature) D Johnson for Darin Duncan

INSTRUCTIONS: Use typewriter or ball point pen. *PLEASE PRESS FIRMLY* and *PRINT* clearly. Please fill in blanks, underline or circle the correct answers. Send top three copies to Kansas Department of Health and Environment, Bureau of Water, Topeka, Kansas 66620-0001. Telephone: 913-296-5545. Send one to WATER WELL OWNER and retain one for your records.