


1 LOCATION OF WATER WELL:	Fraction	Section Number	Township Number	Range Number
County: <u>SALINE</u>	<u>NE</u> 1/4 <u>SE</u> 1/4 <u>SW</u> 1/4	<u>13</u>	T <u>14</u> S	R <u>3</u> EW

Distance and direction from nearest town or city street address of well if located within city?

670 S. 2th

2 WATER WELL OWNER: <u>MARVIN JOHNSON</u>	Board of Agriculture, Division of Water Resources
RR#, St. Address, Box # : <u>501 E. CRAWFORD</u>	Application Number:
City, State, ZIP Code : <u>SALINA, KS. 67401</u>	

3 LOCATE WELL'S LOCATION WITH AN "X" IN SECTION BOX:	4 DEPTH OF COMPLETED WELL: <u>52.8</u> ft. ELEVATION: <u>1226</u>
--	---

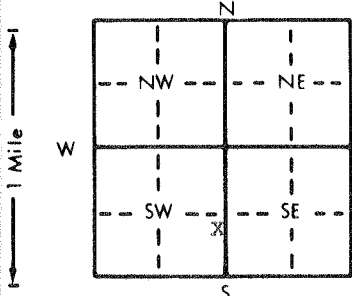

Bore Hole Diameter <u>9</u> in. to <u>60</u> ft. and <u>60</u> in. to <u>60</u> ft.	WELL WATER TO BE USED AS:			
1 Domestic	3 Feedlot	6 Oil field water supply	8 Air conditioning	11 Injection well
2 Irrigation	4 Industrial	7 Lawn and garden only	9 Dewatering	12 Other (Specify below)
Was a chemical/bacteriological sample submitted to Department? Yes <u>X</u> No <u>X</u> ; If yes, mo/day/yr sample was submitted				
Water Well Disinfected? Yes <u>X</u> No <u>X</u>				

5 TYPE OF BLANK CASING USED:	5 Wrought iron	8 Concrete tile	CASING JOINTS: Glued <u>X</u> Clamped <u>X</u>
1 Steel	3 RMP (SR)	6 Asbestos-Cement	9 Other (specify below)
2 PVC	4 ABS	7 Fiberglass	10 Asbestos-cement

TYPE OF SCREEN OR PERFORATION MATERIAL:	10 Asbestos-cement
1 Steel	3 Stainless steel
2 Brass	4 Galvanized steel
3 Fiberglass	6 Concrete tile
8 RMP (SR)	9 ABS
11 Other (specify)	12 None used (open hole)

SCREEN OR PERFORATION OPENINGS ARE:	5 Gauzed wrapped	8 Saw cut	11 None (open hole)
1 Continuous slot	6 Wire wrapped	9 Drilled holes	
2 Louvered shutter	7 Torch cut	10 Other (specify)	
3 Mill slot <u>035</u>			


6 GROUT MATERIAL:	1 Neat cement	2 Cement grout	3 Bentonite	4 Other
Grout Intervals:	From <u>0</u> ft. to <u>24</u> ft.	

What is the nearest source of possible contamination:	10 Livestock pens	14 Abandoned water well
1 Septic tank	11 Fuel storage	15 Oil well/Gas well
2 Sewer lines	12 Fertilizer storage	16 Other (specify below)
3 Watertight sewer lines	13 Insecticide storage	NONE APPARENT
4 Lateral lines		
5 Cess pool		
6 Seepage pit		
7 Pit privy		
8 Sewage lagoon		
9 Feedyard		

Direction from well? How many feet?

FROM	TO	LITHOLOGIC LOG	FROM	TO	PLUGGING INTERVALS
0	4	FILL DIRT			
4	24	CLAY TAN SILTY			
24	60	SAND FINE TO COARSE CLEAN			

7 CONTRACTOR'S OR LANDOWNER'S CERTIFICATION: This water well was (1) constructed, (2) reconstructed, or (3) plugged under my jurisdiction and was completed on (mo/day/year) <u>4-10-96</u> and this record is true to the best of my knowledge and belief. Kansas Water Well Contractor's License No. <u>388</u> This Water Well Record was completed on (mo/day/yr) <u>4-10-96</u> under the business name of <u>PESTINGER PUMP SERVICE</u> by (signature) <u>Paul Pestinger</u>
--