

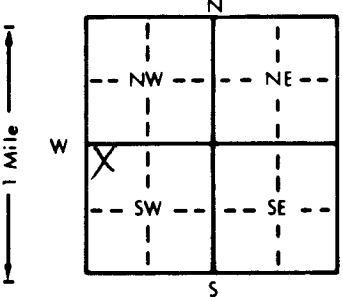
SNMW-3D 231138

WATER WELL RECORD Form WWC-5 KSA 82a-1212

1 LOCATION OF WATER WELL:	Fraction	Section Number	Township Number	Range Number
County: <u>Saline</u>	<u>NW 1/4 NW 1/4 SW 1/4</u>	<u>12</u>	<u>T 14 S</u>	<u>R 3 EW</u>

Distance and direction from nearest town or city street address of well if located within city?
SW of 7th St. & North St. between AT&SF RR tracks & C&I & P RR tracks

2 WATER WELL OWNER:	<u>KDHE</u>	Board of Agriculture, Division of Water Resources
RR#, St. Address, Box # :	<u>Forbes Field Bldg 740</u>	Application Number:
City, State, ZIP Code :	<u>Topeka KS 66620-0001</u>	

3 LOCATE WELL'S LOCATION WITH AN "X" IN SECTION BOX:	4 DEPTH OF COMPLETED WELL: <u>60</u> ft. ELEVATION:
	Depth(s) Groundwater Encountered <u>1. 29.9</u> ft. 2. ft. 3. ft.
	WELL'S STATIC WATER LEVEL <u>25.42</u> ft. below land surface measured on mo/day/yr <u>4-24-96</u>
	Pump test data: Well water was ft. after hours pumping gpm
	Est. Yield gpm: Well water was ft. after hours pumping gpm
	Bore Hole Diameter <u>8.25</u> in. to ft. and in. to ft.
	WELL WATER TO BE USED AS: 5 Public water supply 8 Air conditioning 11 Injection well
	1 Domestic 3 Feedlot 6 Oil field water supply 9 Dewatering 12 Other (Specify below)
	2 Irrigation 4 Industrial 7 Lawn and garden only <u>10 Monitoring well</u>
	Was a chemical/bacteriological sample submitted to Department? Yes No <u>X</u> If yes, mo/day/yr sample was submitted
	Water Well Disinfected? Yes No <u>X</u>

5 TYPE OF BLANK CASING USED:	5 Wrought iron	8 Concrete tile	CASING JOINTS: Glued Clamped
1 Steel	3 RMP (SR)	6 Asbestos-Cement	9 Other (specify below)
<u>2 PVC</u>	4 ABS	7 Fiberglass	Welded
Blank casing diameter <u>2</u> in. to ft. Dia			<u>Threaded</u> <u>Flush</u>
Casing height above land surface <u>Flush</u> in. weight <u>70.3</u> lbs./ft. Wall thickness or gauge No. <u>Sch 40</u>			
TYPE OF SCREEN OR PERFORATION MATERIAL:	<u>7 PVC</u>	10 Asbestos-cement	
1 Steel	3 Stainless steel	5 Fiberglass	8 RMP (SR)
2 Brass	4 Galvanized steel	6 Concrete tile	9 ABS
11 Other (specify)			12 None used (open hole)
SCREEN OR PERFORATION OPENINGS ARE:	5 Gauzed wrapped	8 Saw cut	11 None (open hole)
1 Continuous slot	<u>3 Mill slot</u>	6 Wire wrapped	9 Drilled holes
2 Louvered shutter	4 Key punched	7 Torch cut	10 Other (specify)
SCREEN-PERFORATED INTERVALS:	From <u>50</u> ft. to <u>60</u> ft.	From ft. to ft.	
	From ft. to ft.	From ft. to ft.	
GRAVEL PACK INTERVALS:	From <u>48</u> ft. to <u>60</u> ft.	From ft. to ft.	
	From ft. to ft.	From ft. to ft.	

6 GROUT MATERIAL:	1 Neat cement	2 Cement grout	<u>3 Bentonite</u>	4 Other
Grout Intervals: From <u>0.5</u> ft. to <u>46</u> ft.	From <u>46</u> ft. to <u>48</u> ft.	From ft. to ft.	From ft. to ft.	
What is the nearest source of possible contamination:	1 Septic tank	4 Lateral lines	7 Pit privy	10 Livestock pens
	2 Sewer lines	5 Cess pool	8 Sewage lagoon	11 Fuel storage
	3 Watertight sewer lines	6 Seepage pit	9 Feedyard	12 Fertilizer storage
				13 Insecticide storage
				14 Abandoned water well
				15 Oil well/Gas well
				16 Other (specify below)

Direction from well?	How many feet?
FROM TO LITHOLOGIC LOG FROM TO PLUGGING INTERVALS	
0 0.5 Silt	
0.5 18.5 Silt, some clay	
18.5 23 Sand	
23 29.9 Silty clay	
29.9 31 Sand	
31 31.25 Silt	
31.25 32.5 Sandy silt/silty sand	
32.5 35 Sand w/ silt	
35 36 Silt	
36 38 Sand	
38 38.8 Silt	
38.8 44.6 Sand	
44.6 44.9 Silty clay	
44.9 60 Sand	

7 CONTRACTOR'S OR LANDOWNER'S CERTIFICATION:	This water well was <u>(1) constructed</u> , <u>(2) reconstructed</u> , or <u>(3) plugged</u> under my jurisdiction and was completed on (mo/day/year) <u>4-24-96</u> and this record is true to the best of my knowledge and belief. Kansas
Water Well Contractor's License No. <u>531</u>	This Water Well Record was completed on (mo/day/yr) <u>5-20-96</u>
under the business name of <u>GSI</u>	by (signature) <u>Allison J. J...</u>

INSTRUCTIONS: Use typewriter or ball point pen. PLEASE PRESS FIRMLY and PRINT clearly. Please fill in blanks, underline or circle the correct answers. Send top three copies to Kansas Department of Health and Environment, Bureau of Water, Topeka, Kansas 66620-0001. Telephone: 913-296-5545. Send one to WATER WELL OWNER and retain one for your records.