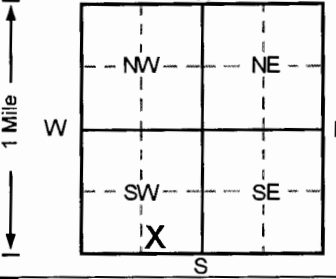


1 LOCATION OF WATER WELL: County: <b>Saline</b>		Fraction <b>SW ¼ SE ¼ SW ¼</b>		Section Number <b>36</b>	Township Number <b>T 14 S</b>	Range Number <b>R 3 E</b> <b>(W)</b>	
Distance and direction from nearest town or city street address of well if located within city? <b>2972 Tasker Lane - Salina, KS</b>	
2 WATER WELL OWNER: <b>Tom Hanavan</b> RR#, St. Address, Box # : <b>2972 Tasker Lane</b> City, State, ZIP Code : <b>Salina, Kansas 67401</b> Board of Agriculture, Division of Water Resources Application Number:	
3 LOCATE WELL'S LOCATION WITH AN "X" IN SECTION BOX: <div style="text-align: center;"></div>		4 DEPTH OF COMPLETED WELL <b>60</b> ft. ELEVATION: Depth(s) Groundwater Encountered 1. .... ft. 2. .... ft. 3. .... ft. WELL'S STATIC WATER LEVEL ..... ft. below land surface measured on mo/day/yr Pump test data: Well water was <b>NA</b> ft. after ..... hours pumping ..... gpm Est. Yield <b>NA</b> gpm: Well water was ..... ft. after ..... hours pumping ..... gpm Bore Hole Diameter <b>8</b> in. to <b>66</b> in. to ..... ft. and ..... in. to ..... ft. WELL WATER TO BE USED AS: 5 Public water supply 8 Air conditioning 11 Injection well 1 Domestic 3 Feedlot 6 Oil field water supply 9 Dewatering 12 Other (Specify below) 2 Irrigation 4 Industrial <b>7</b> Lawn and garden only 10 Monitoring well Was a chemical/bacteriological sample submitted to Department? Yes.....No <b>✓</b> .....; If yes, mo/day/yr sample was submitted Water Well Disinfected? Yes No <b>✓</b>	
5 TYPE OF BLANK CASING USED: 1 Steel 3 RMP (SR) 5 Wrought iron 8 Concrete tile CASING JOINTS: Glued ..... Clamped ..... <b>2</b> PVC 4 ABS 6 Asbestos-Cement 9 Other (specify below) Welded ..... Blank casing diameter ..... 4 ..... in. to ..... 50 ..... ft., Dia ..... in. to ..... ft., Dia ..... in. to ..... ft. Casing height above land surface ..... 30 ..... in., weight ..... lbs./ft. Wall thickness or gauge No. <b>Sch. 40</b> TYPE OF SCREEN OR PERFORATION MATERIAL <b>7</b> PVC 10 Asbestos-cement 1 Steel 3 Stainless steel 5 Fiberglass 8 RMP (SR) 11 Other (specify) ..... 2 Brass 4 Galvanized steel 6 Concrete tile 9 ABS 12 None used (open hole) SCREEN OR PERFORATION OPENINGS ARE: 1 Continuous slot <b>3</b> Mill slot 5 Gauzed wrapped 8 Saw cut 11 None (open hole) 2 Louvered shutter 4 Key punched 6 Wire wrapped 9 Drilled holes 7 Torch cut 10 Other (specify) ..... SCREEN-PERFORATED INTERVALS: From ..... 50 ..... ft. to ..... 60 ..... ft., From ..... ft. to ..... ft. GRAVEL PACK INTERVALS: From ..... 22 ..... ft. to ..... 66 ..... ft., From ..... ft. to ..... ft. From ..... ft. to ..... ft., From ..... ft. to ..... ft.	
6 GROUT MATERIAL: 1 Neat cement 2 Cement grout <b>3</b> Bentonite 4 Other ..... Grout Intervals: From ..... 0 ..... ft. to ..... 22 ..... ft., From ..... ft. to ..... ft., From ..... ft. to ..... ft. What is the nearest source of possible contamination: 1 Septic tank 4 Lateral lines 7 Pit privy 10 Livestock pens 14 Abandoned water well 2 Sewer lines 5 Cess pool 8 Sewage lagoon 11 Fuel storage 15 Oil well/Gas well 3 Watertight sewer lines 6 Seepage pit 9 Feedyard 12 Fertilizer storage 16 Other (specify below) Direction from well? How many feet? 13 Insecticide storage	
<table border="1" style="width:100%; border-collapse: collapse;"><thead><tr><th>FROM</th><th>TO</th><th>LITHOLOGIC LOG</th><th>FROM</th><th>TO</th><th>PLUGGING INTERVALS</th></tr></thead><tbody><tr><td>0</td><td>3</td><td>Clay, Dark Brown</td><td></td><td></td><td></td></tr><tr><td>3</td><td>8</td><td>Clay, Brown</td><td></td><td></td><td></td></tr><tr><td>8</td><td>20</td><td>Clay, Light Brown</td><td></td><td></td><td></td></tr><tr><td>20</td><td>32</td><td>Clay, Light Brown</td><td></td><td></td><td></td></tr><tr><td>32</td><td>38</td><td>Sand, Brown</td><td></td><td></td><td></td></tr><tr><td>38</td><td>44</td><td>Sand, Brown</td><td></td><td></td><td></td></tr><tr><td>44</td><td>48</td><td>Sand, Brown to Gray Brown</td><td></td><td></td><td></td></tr><tr><td>48</td><td>56</td><td>Sand, Brown</td><td></td><td></td><td></td></tr><tr><td>56</td><td>61</td><td>Sand, Brown</td><td></td><td></td><td></td></tr><tr><td>61</td><td>65</td><td>Shale, Brown</td><td></td><td></td><td></td></tr><tr><td>65</td><td>66</td><td>Shale, Gray Brown</td><td></td><td></td><td></td></tr><tr><td></td><td></td><td></td><td></td><td></td><td></td></tr><tr><td></td><td></td><td></td><td></td><td></td><td>LG1, Abovegrade</td></tr><tr><td></td><td></td><td></td><td></td><td></td><td>Project Name: DW-Tasker Lane</td></tr><tr><td></td><td></td><td></td><td></td><td></td><td>GeoCore # 10001, #</td></tr>
7 CONTRACTOR'S OR LANDOWNER'S CERTIFICATION: This water well was <b>(1)</b> constructed, (2) reconstructed, or (3) plugged under my jurisdiction and was completed on (mo/day/year) <b>5/7/96</b> and this record is true to the best of my knowledge and belief. Kansas Water Well Contractor's License No. <b>527</b> This Water Well Record was completed on (mo/day/yr) <b>6/7/96</b> under the business name of <b>GeoCore Services, Inc.</b> by (signature) <i>Paul R. [Signature]</i>	
INSTRUCTIONS: Use typewriter or ball point pen. <b>PLEASE PRESS FIRMLY</b> and <b>PRINT</b> clearly. Please fill in blanks, underline or circle the correct answers. Send top three copies to Kansas Department of Health and Environment, Bureau of Water, Topeka, Kansas 66620-0001. Telephone: 913-296-5545. Send one to WATER WELL OWNER and retain one for your records.	

OFFICE USE ONLY

T

R

EW

SEC.

1/4

1/4

1/4