


1 LOCATION OF WATER WELL: County: <u>Saline</u>	Fraction <u>SW</u> $\frac{1}{4}$ <u>SW</u> $\frac{1}{4}$ <u>NW</u> $\frac{1}{4}$	Section Number <u>25</u>	Township Number T <u>14</u> <u>S</u>	Range Number R <u>3</u> <u>E</u> <u>W</u>
--	---	-----------------------------	---	--

Distance and direction from nearest town or city street address of well if located within city?
2052 Highland

2 WATER WELL OWNER: John Swartz
RR#, St. Address, Box # : 2052 Highland
City, State, ZIP Code : Salina, KS 67401

Board of Agriculture, Division of Water Resources
Application Number: 1227

3 LOCATE WELL'S LOCATION WITH AN "X" IN SECTION BOX: 4 DEPTH OF COMPLETED WELL: 50 ft. ELEVATION: 1231

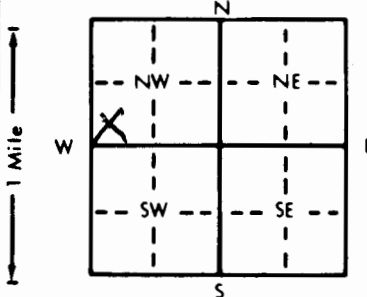

4 DEPTH OF COMPLETED WELL. 50 ft. ELEVATION: 1231
 Depth(s) Groundwater Encountered 1. 26 ft. 2. _____ ft. 3. _____ ft.
 WELL'S STATIC WATER LEVEL 26 ft. below land surface measured on mo/day/yr 4-19-97
 Pump test data: Well water was 28 ft. after 1 hours pumping 15 gpm
 Est. Yield 30 gpm; Well water was _____ ft. after _____ hours pumping _____ gpm
 Bore Hole Diameter 8 1/2 in. to 38 ft., and 5 1/2 in. to 50 ft.
 WELL WATER TO BE USED AS:
 1 Domestic 3 Feedlot 6 Oil field water supply 8 Air conditioning 11 Injection well
 2 Irrigation 4 Industrial (7) Lawn and garden only 10 Monitoring well
 12 Other (Specify below) _____
 Was a chemical/bacteriological sample submitted to Department? Yes _____ No X; If yes, mo/day/yr sample was submitted _____
 Water Well Disinfected? Yes X No _____

5	TYPE OF BLANK CASING USED:	5 Wrought iron	8 Concrete tile	CASING JOINTS: Glued ☒ Clamped ☐
	1 Steel	3 RMP (SR)	6 Asbestos-Cement	9 Other (specify below)
	2 PVC	4 ABS	7 Fiberglass	Welded ☐
				Threaded ☐

Blank casing diameter 5 in. to 14 ft. Dia. 160 lb. in. to 26 ft. Dia. 14 in. to 26 ft. Dia.
Casing height above land surface 14 in. weight 160 lb. lbs./ft. Wall thickness or gauge No. SDR 26

TYPE OF SCREEN OR PERFORATION MATERIAL:

1 Steel	3 Stainless steel	5 Fiberglass	7 PVC	10 Asbestos-cement
2 Brass	4 Galvanized steel	6 Concrete tile	8 RMP (SR)	11 Other (specify)
			9 ABS	12 None used (open hole)



SCREEN OR PERFORATION OPENINGS ARE:

1 Continuous slot	3 Mill slot	5 Gauzed wrapped	8 Saw cut	11 None (open hole)
2 Louvered shutter	4 Key punched	6 Wire wrapped	9 Drilled holes	
		7 Torch cut	10 Other (specify)	

SCREEN-PERFORATED INTERVALS:	From	80	ft. to	30	ft. From	ft. to	ft.
	From		ft. to		ft. From	ft. to	ft.
GRAVEL PACK INTERVALS:	From	21	ft. to	35	ft. From	36	ft. to 50 ft.
	From		ft. to		ft. From		ft. to ft.

8. GROUT MATERIAL: 1 Neat cement 2 Cement grout 3 Bentonite 4 Other
Grout Intervals: From 0 ft. to 21 ft., From ft. to ft., From ft. to ft.

What is the nearest source of possible contamination:

1 Septic tank	4 Lateral lines	7 Pit privy	10 Livestock pens	14 Abandoned water well
2 Sewer lines	5 Cess pool	8 Sewage lagoon	11 Fuel storage	15 Oil well/Gas well
3 Watertight sewer lines	6 Seepage pit	9 Feedyard	12 Fertilizer storage	16 Other (specify below)
			13 Insecticide storage	

Direction from well?		EAST		How many feet?		22	
FROM	TO	LITHOLOGIC LOG	FROM	TO	PLUGGING INTERVALS		

LITHOLOGIC LOG		FROM	TO	PLUGGING INTERVALS
0'	2'	fill dirt		
2'	4'	Top soil		
4'	28'	Light Brown clay AND fine SAND mixed		
28'	39'	Brown clay		
39'	50'	medium to coarse SAND AND Gravel		
50'		Dark Brown clay		

7 CONTRACTOR'S OR LANDOWNER'S CERTIFICATION: This water well was (1) constructed, (2) reconstructed, or (3) plugged under my jurisdiction and was completed on (mo/day/year) 4-21-97 and this record is true to the best of my knowledge and belief. Kansas Water Well Contractor's License No. 523 This Water Well Record was completed on (mo/day/yr) under the business name of M & D Well Service by (signature) Matthew Soukup