

1 LOCATION OF WATER WELL: County: <u>Saline</u>		Fraction <u>NW</u> $\frac{1}{4}$ <u>NW</u> $\frac{1}{4}$ <u>SW</u> $\frac{1}{4}$	Section Number <u>33</u>	Township Number T <u>14</u> S	Range Number R <u>3</u> <u>NW</u>
--	--	---	-----------------------------	----------------------------------	--------------------------------------

Distance and direction from nearest town or city street address of well if located within city?  
Well # 03M52 @ Former Schilling AFB, Salina KS


2 WATER WELL OWNER: USACE 90 Burns & McDonnell

RR#, St. Address, Box # : 9400 Ward Pkwy  
City, State, ZIP Code : Kansas City MO 64114

Board of Agriculture, Division of Water Resources  
Application Number: \_\_\_\_\_

3 LOCATE WELL'S LOCATION WITH AN "X" IN SECTION BOX:

4 DEPTH OF COMPLETED WELL . . . 18.3 . . . ft. ELEVATION: . . . . .

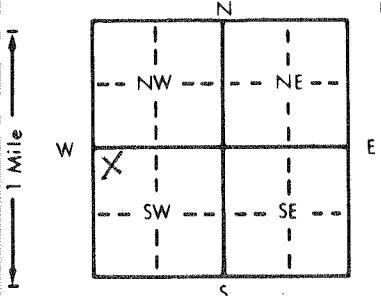

Depth(s) Groundwater Encountered 1. .... ft. 2. .... ft. 3. .... ft.

WELL'S STATIC WATER LEVEL ..... ft. below land surface measured on mo/day/yr .....

Pump test data: Well water was ..... ft. after ..... hours pumping ..... gpm

Est. Yield ..... gpm: Well water was ..... ft. after ..... hours pumping ..... gpm

Bore Hole Diameter. 8 in. to 10.3 ft., and ..... in. to ..... ft.

WELL WATER TO BE USED AS:

5 Public water supply	8 Air conditioning	11 Injection well		
1 Domestic	3 Feedlot	6 Oil field water supply	9 Dewatering	12 Other (Specify below)
2 Irrigation	4 Industrial	7 Lawn and garden only	<u>10</u> Monitoring well	

Was a chemical/bacteriological sample submitted to Department? Yes.....No X.....; If yes, mo/day/yr sample was submitted

Water Well Disinfected? Yes ..... No .....

5 TYPE OF BLANK CASING USED:

5 Wrought iron      8 Concrete tile      CASING JOINTS: Glued . . . . . Clamped . . . . .

1 Steel 3 RMP (SR) 6 Asbestos-Cement 9 Other (specify below) Welded  
 ② PVC 4 ABS 7 Fiberglass Threaded **X**  
 Blank casing diameter **2** in. to **12.3** ft. Dia in. to ft. Dia in. to ft.  
 Casing height above land surface **30** in. weight lbs./ft. Wall thickness or gauge No. **Sch 40**

TYPE OF SCREEN OR PERFORATION MATERIAL:			⑦ PVC	10 Asbestos-cement
1 Steel	3 Stainless steel	5 Fiberglass	8 RMP (SR)	11 Other (specify) .....
2 Brass	4 Galvanized steel	6 Concrete tile	9 ABS	12 None used (open hole)

SCREEN OR PERFORATION OPENINGS ARE:

1 Continuous slot	3 Mill slot	5 Gauzed wrapped	8 Saw cut	11 None (open hole)
2 Louvered shutter	4 Key punched	6 Wire wrapped	9 Drilled holes	
		7 Torch cut	10 Other (specify) .....	

SCREEN-PERFORATED INTERVALS:	From	12.3	ft. to	17.5	ft., From	ft. to	ft.
	From		ft. to		ft., From	ft. to	ft.
GRAVEL PACK INTERVALS:	From	9	ft. to	18.3	ft., From	ft. to	ft.
	From		ft. to		ft., From	ft. to	ft.

6. GROUT MATERIAL: 1 Neat cement 2 Cement grout 3 Bentonite 4 Other  
Grout Intervals: From 3 ft. to 9 ft., From ft. to ft., From ft. to ft.

What is the nearest source of possible contamination:

1 Septic tank	4 Lateral lines	7 Pit privy	10 Livestock pens	14 Abandoned water well
2 Sewer lines	5 Cess pool	8 Sewage lagoon	11 Fuel storage	15 Oil well/Gas well
3 Watertight sewer lines	6 Seepage pit	9 Feedyard	12 Fertilizer storage	16 Other (specify below)
			13 Insecticide storage	Former AFB

Direction from well? \_\_\_\_\_ How many feet? \_\_\_\_\_

[illegible]

7 CONTRACTOR'S OR LANDOWNER'S CERTIFICATION: This water well was (1) constructed, (2) reconstructed, or (3) plugged under my jurisdiction and was completed on (mo/day/year) 7/11/97 and this record is true to the best of my knowledge and belief. Kansas Water Well Contractor's License No. 570 This Water Well Record was completed on (mo/day/yr) 9/3/97 under the business name of AQUADRILL, INC. by (signature) Dave DeShyn