

1 LOCATION OF WATER WELL:	Fraction	Section Number	Township Number	Range Number
County: <u>Saline</u>	<u>SE</u> $\frac{1}{4}$ <u>SW</u> $\frac{1}{4}$ <u>SE</u> $\frac{1}{4}$	<u>15</u>	<u>T</u> <u>14</u> <u>S</u>	<u>R</u> <u>3</u> <u>E(W)</u>

Distance and direction from nearest town or city street address of well if located within city?

671 Westport Blvd., Salina, Ks. 67401 MW 1

2 WATER WELL OWNER: Midway USA Conoco

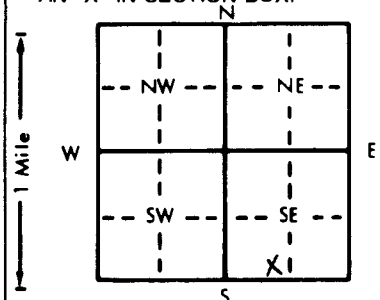
RR#, St. Address, Box # : 671 Westport

Board of Agriculture, Division of Water Resources

City, State, ZIP Code : Salina, Ks. 67401

Application Number:

3 LOCATE WELL'S LOCATION WITH AN "X" IN SECTION BOX:


WELL WATER TO BE USED AS: 5 Public water supply 8 Air conditioning 11 Injection well

1 Domestic 3 Feedlot 6 Oil field water supply 9 Dewatering 12 Other (Specify below)

2 Irrigation 4 Industrial 7 Lawn and garden only 10 Monitoring wellWas a chemical/bacteriological sample submitted to Department? Yes No ☒; If yes, mo/day/yr sample was submittedWater Well Disinfected? Yes No ☒

5 TYPE OF BLANK CASING USED:

5 Wrought iron

8 Concrete tile

CASING JOINTS: Glued Clamped

1 Steel

3 RMP (SR)

6 Asbestos-Cement

9 Other (specify below)

Welded

2 PVC

4 ABS

7 Fiberglass


TYPE OF SCREEN OR PERFORATION MATERIAL:

1 Steel

3 Stainless steel

5 Fiberglass

2 PVC

10 Asbestos-cement

2 Brass

4 Galvanized steel

6 Concrete tile

8 RMP (SR)

11 Other (specify)

1 Continuous slot

3 Mill slot

5 Gauzed wrapped

8 Saw cut

11 None (open hole)

2 Louvered shutter

4 Key punched

6 Wire wrapped

9 Drilled holes

7 Torch cut

10 Other (specify)


6 GROUT MATERIAL:

1 Neat cement

2 Cement grout

3 Bentonite

4 Other

Grout Intervals: From 0 ft. to 1 (cement) ft., From 1 ft. to 19 (bent) ft., From 19 ft. to 19 ft.

What is the nearest source of possible contamination:

1 Septic tank

4 Lateral lines

7 Pit privy

10 Livestock pens

14 Abandoned water well

2 Sewer lines

5 Cess pool

8 Sewage lagoon

11 Fuel storage

15 Oil well/Gas well

3 Watertight sewer lines

6 Seepage pit

9 Feedyard

12 Fertilizer storage

16 Other (specify below)

13 Insecticide storage

Direction from well? WestHow many feet? 4

FROM	TO	LITHOLOGIC LOG	FROM	TO	PLUGGING INTERVALS
0	13	Silty clay, black			Flush Mount Cover
13	22	Silty clay, greyish brown			KDHE Site ID# 00099321
22	30	Clay, grey			
30	33	Silty clay, greyish brown			
33	36.5	Sandy clay, reddish brown			
36.5	43	Sand, yellowish brown			

7 CONTRACTOR'S OR LANDOWNER'S CERTIFICATION: This water well was (1) constructed, (2) reconstructed, or (3) plugged under my jurisdiction and was

completed on (mo/day/year) 2-25-92 and this record is true to the best of my knowledge and belief. KansasWater Well Contractor's License No. 527 This Water Well Record was completed on (mo/day/yr) 2-26-92under the business name of GeoCore Services, Inc. by (signature) Dale A. Bell

INSTRUCTIONS: Use typewriter or ball point pen. PLEASE PRESS FIRMLY and PRINT clearly. Please fill in blanks, underline or circle the correct answers. Send top three copies to Kansas Department of Health and Environment, Bureau of Water, Topeka, Kansas 66620-0001. Telephone: 913-296-5545. Send one to WATER WELL OWNER and retain one for your records.