


1) LOCATION OF WATER WELL: County: <u>Saline</u>	Fraction <u>NE</u> $\frac{1}{4}$ <u>NE</u> $\frac{1}{4}$ <u>NW</u> $\frac{1}{4}$	Section Number <u>15</u>	Township Number T <u>14</u> S	Range Number R <u>3</u> <u>EW</u>
---	---	-----------------------------	----------------------------------	--------------------------------------

Distance and direction from nearest town or city street address of well if located within city?
 7137 W. Old Hwy 40. Salina

2] WATER WELL OWNER:	ST Services	
RR#, St. Address, Box # :	17304 Preston Rd ste. 1000	Board of Agriculture, Division of Water Resources
City, State, ZIP Code :	Dallas TX 75252	Application Number:

3 LOCATE WELL'S LOCATION WITH AN "X" IN SECTION BOX: 4 DEPTH OF COMPLETED WELL: 19 ft. ELEVATION: 13 ft.
 Depth(s) Groundwater Encountered 1 13 ft. 2 ft. 3 ft.

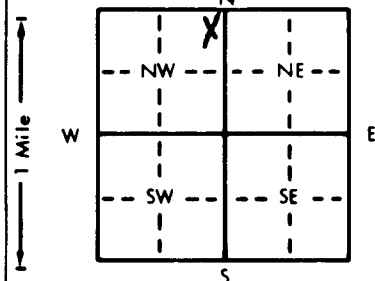

4 DEPTH OF COMPLETED WELL 19 ft. ELEVATION:
 Depth(s) Groundwater Encountered 1 8 1/3 ft. 2. ft. 3. ft.
 WELL'S STATIC WATER LEVEL 8 1/3 ft. below land surface measured on mo/day/yr 4/21/00
 Pump test data: Well water was ft. after hours pumping gpm
 Est. Yield gpm Well water was ft. after hours pumping gpm
 Bore Hole Diameter 8 in. to 19 in. to ft. and in. to ft.
 WELL WATER TO BE USED AS: 5 Public water supply 8 Air conditioning 11 Injection well
 1 Domestic 3 Feedlot 6 Oil field water supply 9 Dewatering 12 Other (Specify below)
 2 Irrigation 4 Industrial 7 Lawn and garden only 10 Monitoring well
 Was a chemical/bacteriological sample submitted to Department? Yes No X If yes, mo/day/yr sample was sub-
 mitted Water Well Disinfected? Yes No X

5 TYPE OF BLANK CASING USED: 5 Wrought iron 8 Concrete tile CASING JOINTS: Glued Clamped
1 Steel 3 RMP (SR) 6 Asbestos-Cement 9 Other (specify below) Welded
2 PVC 4 ABS 7 Fiberglass Threaded *Flush*
Blank casing diameter 2 in. to 9 ft. Dia. in. to ft. Dia. in. to ft.
Casing height above land surface 36 in. weight 70.3 lbs./ft. Wall thickness or gauge No. Sch 40

TYPE OF SCREEN OR PERFORATION MATERIAL:					7 PVC	10 Asbestos-cement
1 Steel	3 Stainless steel	5 Fiberglass	8 RMP (SR)	11 Other (specify)		
2 Brass	4 Galvanized steel	6 Concrete tile	9 ABS	12 None used (open hole)		

SCREEN OR PERFORATION OPENINGS ARE:

1 Continuous slot	3 Mill slot	5 Gauzed wrapped	8 Saw cut	11 None (open hole)
2 Louvered shutter	4 Key punched	6 Wire wrapped	9 Drilled holes	
		7 Torch cut	10 Other (specify)	

SCREEN-PERFORATED INTERVALS:	From	1	ft. to	11	ft., From		ft. to		ft.
	From		ft. to		ft., From		ft. to		ft.
GRAVEL PACK INTERVALS:	From	7	ft. to	19	ft., From		ft. to		ft.
	From		ft. to		ft., From		ft. to		ft.

6 GROUT MATERIAL: 1 Neat cement 2 Cement grout 3 Bentonite 4 Other
Grout Intervals: From 1 ft. to 7 ft., From ft. to ft., From ft. to ft.

What is the nearest source of possible contamination:				10 Livestock pens	14 Abandoned water well
1 Septic tank	4 Lateral lines	7 Pit privy	11 Fuel storage	15 Oil well/Gas well	
2 Sewer lines	5 Cess pool	8 Sewage lagoon	12 Fertilizer storage	16 Other (specify below)	
3 Watertight sewer lines	6 Seepage pit	9 Feedyard	13 Insecticide storage		

Direction from well?		How many feet?
----------------------	--	----------------

[illegible]

7 CONTRACTOR'S OR LANDOWNER'S CERTIFICATION: This water well was (1) constructed, (2) reconstructed, or (3) plugged under my jurisdiction and was completed on (mo/day/year) 4/21/00 and this record is true to the best of my knowledge and belief. Kansas Water Well Contractor's License No. 531 This Water Well Record was completed on (mo/day/yr) 5/11/00 under the business name of Geotechnical Services, Inc. by (signature) Alissa M. Smith