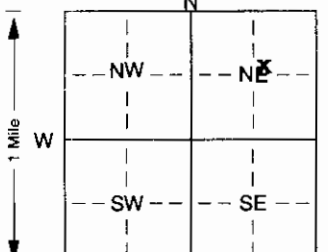


KSA 82a-1212 ID No.

1 LOCATION OF WATER WELL:		Fraction		Section Number		Township Number		Range Number			
County: <u>SALINE</u>		<u>SW</u> $\frac{1}{4}$ <u>NE</u> $\frac{1}{4}$ <u>NE</u> $\frac{1}{4}$		<u>11</u>		<u>T</u> <u>14</u> <u>S</u>		<u>R</u> <u>3W</u> <u>EW</u>			
Distance and direction from nearest town or city street address of well if located within city? <u>1368 W. GRAND AV.</u> <u>SALINE COUNTY PERMIT#00-220</u>											
2 WATER WELL OWNER: <u>KING WINDOW COVERINGS</u>											
RR#, St. Address, Box # : <u>1368 W. GRAND AV.</u>						Board of Agriculture, Division of Water Resources					
City, State, ZIP Code : <u>SALINA, KS. 67401</u>						Application Number:					
3 LOCATE WELL'S LOCATION WITH 4 DEPTH OF COMPLETED WELL <u>60'6"</u> ft. ELEVATION: <u>1229</u>											
AN "X" IN SECTION BOX:			Depth(s) Groundwater Encountered 1. <u>32</u> ft. 2. ft. 3. ft.								
			WELL'S STATIC WATER LEVEL <u>16</u> ft. below land surface measured on mo/day/yr <u>6-9-00</u>								
			Pump test data: Well water was <u>20</u> ft. after <u>2</u> hours pumping <u>25</u> gpm								
			Est. Yield <u>75+</u> gpm; Well water was ft. after hours pumping gpm								
			Bore Hole Diameter <u>9</u> in. to <u>61</u> ft., and in. to ft.								
			WELL WATER TO BE USED AS: 5 Public water supply 8 Air conditioning 11 Injection well								
			1 Domestic 3 Feedlot 6 Oil field water supply 9 Dewatering 12 Other (Specify below)								
			2 Irrigation 4 Industrial 7 Domestic (lawn & garden) 10 Monitoring well								
Was a chemical/bacteriological sample submitted to Department? Yes. No. <u>X</u> ; If yes, mo/day/yr sample was submitted											
Water Well Disinfected? Yes <u>X</u> No											
5 TYPE OF BLANK CASING USED: 5 Wrought iron 8 Concrete tile CASING JOINTS: Glued. <u>X</u> Clamped.											
1 Steel 3 RMP (SR) 6 Asbestos-Cement 9 Other (specify below) Welded											
2 PVC 4 ABS 7 Fiberglass Threaded											
Blank casing diameter <u>5</u> in. to <u>51'6"</u> ft., Dia in. to ft., Dia in. to ft.											
Casing height above land surface <u>24</u> in., weight <u>160</u> lbs./ft. Wall thickness or gauge No. <u>SDR 26</u>											
TYPE OF SCREEN OR PERFORATION MATERIAL: <u>7 PVC</u> 10 Asbestos-cement											
1 Steel 3 Stainless steel 5 Fiberglass 8 RMP (SR) 11 Other (specify)											
2 Brass 4 Galvanized steel 6 Concrete tile 9 ABS 12 None used (open hole)											
SCREEN OR PERFORATION OPENINGS ARE: 5 Gauzed wrapped 8 Saw cut 11 None (open hole)											
1 Continuous slot 3 Mill slot <u>.025</u> 6 Wire wrapped 9 Drilled holes											
2 Louvered shutter 4 Key punched 7 Torch cut 10 Other (specify) ft.											
SCREEN-PERFORATED INTERVALS: From <u>51'6"</u> ft. to <u>61'6"</u> ft., From ft. to ft.											
From ft. to ft., From ft. to ft.											
GRAVEL PACK INTERVALS: From <u>35</u> ft. to <u>61'6"</u> ft., From ft. to ft.											
From ft. to ft., From ft. to ft.											
6 GROUT MATERIAL: 1 Neat cement 2 Cement grout <u>3 Bentonite</u> 4 Other											
Grout Intervals: From <u>0</u> ft. to <u>35</u> ft., From ft. to ft., From ft. to ft.											
What is the nearest source of possible contamination: 10 Livestock pens 14 Abandoned water well											
1 Septic tank 4 Lateral lines 7 Pit privy 11 Fuel storage 15 Oil well/Gas well											
2 Sewer lines 5 Cess pool 8 Sewage lagoon 12 Fertilizer storage 16 Other (specify below)											
3 Watertight sewer lines 6 Seepage pit 9 Feedyard 13 Insecticide storage											
Direction from well? <u>EAST</u> How many feet? <u>56</u>											
FROM		TO		LITHOLOGIC LOG		FROM		TO		PLUGGING INTERVALS	
0		1		FILL DIRT							
1		3		TOP SOIL							
3		5		CLAY BROWN SILTY							
5		24		CLAY BLACK PLASTIC							
24		32		CLAY BROWN SILTY							
32		54		SAND FINE TO MED. TAN							
54		61		SAND FINE TO COARSE BROWN							
7 CONTRACTOR'S OR LANDOWNER'S CERTIFICATION: This water well was (1) constructed, (2) reconstructed, or (3) plugged under my jurisdiction and was completed on (mo/day/year) <u>6-9-00</u> and this record is true to the best of my knowledge and belief. Kansas Water Well Contractor's Licence No. <u>388</u> This Water Well Record was completed on (mo/day/yr) <u>6-15-00</u> under the business name of <u>PESTINGER PUMP SERVICE</u> by (signature) <u>[Signature]</u>											
INSTRUCTIONS: Use typewriter or ball point pen. PLEASE PRESS FIRMLY and PRINT clearly. Please fill in blanks, underline or circle the correct answers. Send top three copies to Kansas Department of Health and Environment, Bureau of Water, Topeka, Kansas 66620-0001. Telephone 785-296-5524. Send one to WATER WELL OWNER and retain one for your records. Fee of \$5.00 for each constructed well.											