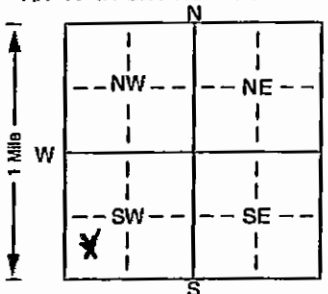


KSA 82a-1212 ID No.

1) LOCATION OF WATER WELL: County: <u>Saline</u>		Fraction: <u>NW 1/4 SW 1/4 SW 1/4</u>		Section Number: <u>23</u>		Township Number: <u>T 14</u>		Range Number: <u>S 3</u>		Elev: <u>EW</u>	
Distance and direction from nearest town or city street address of well if located within city: <u>1607 Hickory, Salina, Ks</u>											
2) WATER WELL OWNER: <u>Be ma</u> RR#, St. Address, Box #: <u>1607 Hickory</u> City, State, ZIP Code: <u>Salina, Ks 67401</u>											
Board of Agriculture, Division of Water Resources Application Number:											
3) LOCATE WELL'S LOCATION WITH AN "X" IN SECTION BOX:				4) DEPTH OF COMPLETED WELL: <u>58</u> ft. ELEVATION: <u>58</u> ft.							
				Depth(s) Groundwater Encountered 1. <u>30.3</u> ft. 2. <u>30.3</u> ft. 3. <u>8/29/02</u> ft.							
				WELL'S STATIC WATER LEVEL <u>30.3</u> ft. below land surface measured on mo/day/yr							
				Pump test data: Well water was _____ ft. after _____ hours pumping _____ gpm							
				Est. Yield <u>30</u> gpm: Well water was _____ ft. after _____ hours pumping _____ gpm							
Bore Hole Diameter: <u>9</u> in. to <u>6.0</u> in. to _____ in. to _____ in.				WELL WATER TO BE USED AS: 5 Public water supply 8 Air conditioning 11 Injection well 1 Domestic 3 Feedlot 6 Oil field water supply 9 Dewatering 12 Other (Specify below) 2 Irrigation 4 Industrial <u>7</u> Domestic (lawn & garden) 10 Monitoring well							
Was a chemical/bacteriological sample submitted to Department? Yes. _____ No. <u>✓</u> If yes, mo/day/yr sample was submitted _____											
Water Well Disinfected? Yes <u>✓</u> No _____											
5) TYPE OF BLANK CASING USED:											
1 Steel 3 RMP (SR) 5 Wrought iron 8 Concrete tile CASING JOINTS: Glued. <u>✓</u> Clamped. _____ <u>2 PVC</u> 4 ABS 6 Asbestos-Cement 9 Other (specify below) Welded _____ 7 Fiberglass Threaded _____											
Blank casing diameter <u>5</u> in. to <u>58</u> in. Dia _____ in. to _____ in. Dia _____ in. to _____ in.											
Casing height above land surface <u>15</u> in. weight <u>5.1</u> lbs./ft. Wall thickness or gauge No. _____											
TYPE OF SCREEN OR PERFORATION MATERIAL:											
1 Steel 3 Stainless steel 5 Fiberglass <u>7 PVC</u> 10 Asbestos-cement 2 Brass 4 Galvanized steel 6 Concrete tile 8 RMP (SR) 11 Other (specify) _____ 9 ABS 12 None used (open hole)											
SCREEN OR PERFORATION OPENINGS ARE:											
1 Continuous slot <u>3 Mill slot</u> 5 Gauzed wrapped 8 Saw cut 11 None (open hole) 2 Louvered shutter 4 Key punched 6 Wire wrapped 9 Drilled holes 7 Torch cut 10 Other (specify) _____											
SCREEN-PERFORATED INTERVALS: From <u>58</u> ft. to <u>46</u> ft. From _____ ft. to _____ ft.											
GRAVEL PACK INTERVALS: From <u>60</u> ft. to <u>20</u> ft. From _____ ft. to _____ ft.											
6) GROUT MATERIAL: 1 Neat cement 2 Cement grout <u>3 Bentonite</u> 4 Other _____											
Grout Intervals: From <u>20</u> ft. to <u>0</u> ft. From _____ ft. to _____ ft.											
What is the nearest source of possible contamination:											
1 Septic tank 4 Lateral lines 7 Pit privy 10 Livestock pens 14 Abandoned water well 2 Sewer lines 5 Cess pool 8 Sewage lagoon 11 Fuel storage 15 Oil well/Gas well <u>3</u> Watertight sewer lines 6 Seepage pit 9 Feedyard 12 Fertilizer storage 16 Other (specify below) _____ 13 Insecticide storage _____											
Direction from well? <u>W</u> How many feet? <u>75</u>											
FROM TO LITHOLOGIC LOG FROM TO PLUGGING INTERVALS											
<u>0</u> <u>8</u> <u>Clay - brown</u> _____											
<u>8</u> <u>14</u> <u>Clay - silty, light brown</u> _____											
<u>14</u> <u>36</u> <u>Clay - silty, reddish brown</u> _____											
<u>36</u> <u>40</u> <u>Clay - trace sand, brown</u> _____											
<u>40</u> <u>44</u> <u>clay - sandy, dk. gray</u> _____											
<u>44</u> <u>58</u> <u>Sand - f-c w/ clay lenses</u> _____											
<u>58</u> <u>60</u> <u>Shale</u> _____											
7) CONTRACTOR'S OR LANDOWNER'S CERTIFICATION: This water well was <u>(1)</u> constructed, <u>(2)</u> reconstructed, or <u>(3)</u> plugged under my jurisdiction and was completed on (mo/day/year) <u>8/29/02</u> and this record is true to the best of my knowledge and belief. Kansas Water Well Contractor's Licence No. <u>527</u> This Water Well Record was completed on (mo/day/yr) <u>9/9/02</u> under the business name of <u>GeoCore Inc</u> by (signature) <u>Dale Ruhl</u>											
INSTRUCTIONS: Use typewriter or ball point pen. PLEASE PRESS FIRMLY and PRINT clearly. Please fill in blanks, underline or circle the correct answers. Send top three copies to Kansas Department of Health and Environment, Bureau of Water, Topeka, Kansas 66620-0001. Telephone 785-298-5524. Send one to WATER WELL OWNER and retain one for your records. Fee of \$5.00 for each constructed well.											