

1 LOCATION OF WATER WELL:	Fraction	Section Number	Township Number	Range Number
County: <u>SALINE</u>	<u>NE</u> $\frac{1}{4}$ <u>SW</u> $\frac{1}{4}$ <u>NW</u> $\frac{1}{4}$	<u>36</u>	<u>T</u> <u>14</u> <u>S</u>	<u>R</u> <u>3W</u> <u>EW</u>

Distance and direction from nearest town or city street address of well if located within city?

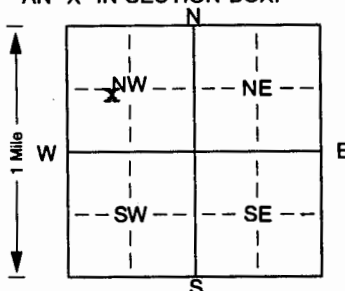
116 E. KEY AVE.2 WATER WELL OWNER: GARY GILPINRR#, St. Address, Box # : 116 E. KEY AVE.City, State, ZIP Code : SALINA, KS. 67401

Board of Agriculture, Division of Water Resources

Application Number:

3 LOCATE WELL'S LOCATION WITH 4 DEPTH OF COMPLETED WELL. 62 ft. ELEVATION: 1240

AN "X" IN SECTION BOX:

Depth(s) Groundwater Encountered 1. 24 ft. 2. 24 ft. 3. 24 ft.WELL'S STATIC WATER LEVEL 24 ft. below land surface measured on mo/day/yr 6-12-02Pump test data: Well water was 27 ft. after 1 hours pumping 25 gpmEst. Yield 75 gpm: Well water was 27 ft. after 1 hours pumping 25 gpmBore Hole Diameter. 10 in. to 62 ft., and 62 in. to 62 ft.

WELL WATER TO BE USED AS: 5 Public water supply 8 Air conditioning 11 Injection well

1 Domestic 3 Feedlot 6 Oil field water supply 9 Dewatering 12 Other (Specify below)

2 Irrigation 4 Industrial 7 Domestic (lawn & garden) 10 Monitoring well

Was a chemical/bacteriological sample submitted to Department? Yes. No X; If yes, mo/day/yr sample was submitted Water Well Disinfected? Yes X No5 TYPE OF BLANK CASING USED: 5 Wrought iron 8 Concrete tile CASING JOINTS: Glued. X Clamped. X1 Steel 3 RMP (SR) 6 Asbestos-Cement 9 Other (specify below) Welded X2 PVC 4 ABS 7 Fiberglass Threaded XBlank casing diameter 5 in. to 52 ft., Dia 52 in. to 52 ft., Dia 52 in. to 52 ft.Casing height above land surface 16 in., weight 160 lbs./ft. Wall thickness or gauge No. SDR 26

TYPE OF SCREEN OR PERFORATION MATERIAL:

1 Steel 3 Stainless steel 5 Fiberglass 7 RMP (SR) 10 Asbestos-cement

2 Brass 4 Galvanized steel 6 Concrete tile 9 ABS 11 Other (specify) 12

SCREEN OR PERFORATION OPENINGS ARE: 5 Gauzed wrapped 8 Saw cut 11 None (open hole)

1 Continuous slot 3 Mill slot .025 6 Wire wrapped 9 Drilled holes2 Louvered shutter 4 Key punched 7 Torch cut 10 Other (specify) 12SCREEN-PERFORATED INTERVALS: From 52 ft. to 62 ft., From 52 ft. to 62 ft.From 52 ft. to 62 ft., From 52 ft. to 62 ft.GRAVEL PACK INTERVALS: From 22 ft. to 62 ft., From 22 ft. to 62 ft.From 22 ft. to 62 ft., From 22 ft. to 62 ft.

6 GROUT MATERIAL: 1 Neat cement 2 Cement grout 3 Bentonite 4 Other

Grout Intervals: From 0 ft. to 22 ft., From 0 ft. to 22 ft., From 0 ft. to 22 ft.

What is the nearest source of possible contamination:

1 Septic tank 4 Lateral lines 7 Pit privy 10 Livestock pens 14 Abandoned water well

2 Sewer lines 5 Cess pool 8 Sewage lagoon 11 Fuel storage 15 Oil well/Gas well

3 Watertight sewer lines 6 Seepage pit 9 Feedyard 12 Fertilizer storage 16 Other (specify below)

Direction from well? WEST How many feet? 65

FROM TO LITHOLOGIC LOG FROM TO PLUGGING INTERVALS

0 2 FILL DIRT

2 29 CLAY BROWN SILTY

29 62 SAND FINE TO MED. TAN

62 CLAY GRAY

7 CONTRACTOR'S OR LANDOWNER'S CERTIFICATION: This water well was (1) constructed, (2) reconstructed, or (3) plugged under my jurisdiction and was completed on (mo/day/year) 6-12-02 and this record is true to the best of my knowledge and belief. KansasWater Well Contractor's Licence No. 388 This Water Well Record was completed on (mo/day/yr) 6-12-02under the business name of PESTINGER PUMP SERVICE by (signature) [Signature]