

County: Saline Fraction E2 NE NE SE Sec. 25 T 14 S R 3 E (W)

CORRECTION(S) TO WATER WELL COMPLETION RECORD (WWC-5)

(to rectify lacking or incorrect information)

Owner: Bennington State Bank

Location was listed as:

Location changed to:

Section-Township-Range: 25-145-3W

25-145-3W

Fraction ( $\frac{1}{4}$   $\frac{1}{4}$   $\frac{1}{4}$ ): NE NE SW

E2 NE NE SE

Other changes: Initial statements: \_\_\_\_\_

Changed to: \_\_\_\_\_

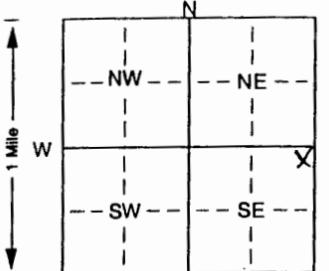
Comments: \_\_\_\_\_

Verification method: well site address, city street map, and  
mapping tool on KGS website.

initials: DRA date: 1/4/2016

Submitted by: Kansas Geological Survey, Data Resources Library, 1930 Constant Ave., Lawrence, KS 66047-3726

to: Kansas Dept of Health & Environment, Bureau of Water, 1000 SW Jackson, Suite 420, Topeka, KS 66612-1367.

1 LOCATION OF WATER WELL: Fraction		Section Number		Township Number		Range Number	
County: SALINE NE 1/4 NE 1/4 SW 1/4		25		T 14 S		R 3 EW	
Distance and direction from nearest town or city street address of well if located within city? 2130 S. OHIO, SALINA, KANSAS							
2 WATER WELL OWNER: BEVININGTON STATE BANK							
RR#, St. Address, Box # : 2130 S. OHIO				Board of Agriculture, Division of Water Resources			
City, State, ZIP Code : SALINA, KANSAS				Application Number:			
3 LOCATE WELL'S LOCATION WITH AN "X" IN SECTION BOX:		4 DEPTH OF COMPLETED WELL: 49.7 ft. ELEVATION:					
		Depth(s) Groundwater Encountered 1. ft. 2. ft. 3. ft. WELL'S STATIC WATER LEVEL 18.5 ft. below land surface measured on mo/day/yr 9/27/02 Pump test data: Well water was ft. after hours pumping gpm Est. Yield 50 gpm: Well water was ft. after hours pumping gpm Bore Hole Diameter 9" in. to 20' ft., and 8" in. to 52' ft. WELL WATER TO BE USED AS: 5 Public water supply 8 Air conditioning 11 Injection well 1 Domestic 3 Feedlot 6 Oil field water supply 9 Dewatering 12 Other (Specify below) 2 Irrigation 4 Industrial 7 Domestic (lawn & garden) 10 Monitoring well Was a chemical/bacteriological sample submitted to Department? Yes. No. If yes, mo/day/yr sample was submitted Water Well Disinfected? Yes No					
5 TYPE OF BLANK CASING USED: 1 Steel 2 RMP (SR) 3 Stainless steel 4 Galvanized steel 5 Wrought iron 6 Asbestos-Cement 7 Fiberglass 8 Concrete tile 9 Other (specify below) CASING JOINTS: Glued. Clamped. Welded. Threaded. Blank casing diameter 5 in. to 34.7 ft. Dia in. to ft. Dia in. to ft. Casing height above land surface 18 in., weight lbs./ft. Wall thickness or gauge No. Sch. 40 TYPE OF SCREEN OR PERFORATION MATERIAL: 1 Steel 3 Stainless steel 5 Fiberglass 7 PVC 8 RMP (SR) 10 Asbestos-cement 11 Other (specify) 12 None used (open hole) 2 Brass 4 Galvanized steel 6 Concrete tile 9 ABS 12 None used (open hole) SCREEN OR PERFORATION OPENINGS ARE: 1 Continuous slot 2 Mill slot 3 Gauzed wrapped 4 Wire wrapped 5 Saw cut 6 Drilled holes 7 None (open hole) 2 Louvered shutter 4 Key punched 7 Torch cut 10 Other (specify) ft. SCREEN-PERFORATED INTERVALS: From 34.7 ft. to 49.7 ft. From ft. to ft. From ft. to ft. From ft. to ft. GRAVEL PACK INTERVALS: From 21 ft. to 52 ft. From ft. to ft. From ft. to ft. From ft. to ft.							
6 GROUT MATERIAL: 1 Neat cement 2 Cement grout 3 Bentonite 4 Other Grout Intervals: From 0 ft. to 21 ft. From ft. to ft. From ft. to ft. From ft. to ft. What is the nearest source of possible contamination: 1 Septic tank 4 Lateral lines 7 Pit privy 10 Livestock pens 14 Abandoned water well 2 Sewer lines 5 Cess pool 8 Sewage lagoon 11 Fuel storage 15 Oil well/Gas well 3 Watertight sewer lines 6 Seepage pit 9 Feedyard 12 Fertilizer storage 16 Other (specify below) Direction from well? EAST How many feet? 50							
FROM TO		LITHOLOGIC LOG		FROM TO		PLUGGING INTERVALS	
0	12	Clay - Brown, Silty					
12	18	Clay - very silty, very sandy					
18	25	Sand and Gravel					
25	30	Sand and Gravel with Wood.					
30	47	Sand and Gravel					
47	49	Clay - Gray					
49	50	Gravel					
50	51	Clay					
51	52	Shale					
7 CONTRACTOR'S OR LANDOWNER'S CERTIFICATION: This water well was 1 constructed, (2) reconstructed, or (3) plugged under my jurisdiction and was completed on (mo/day/year) 9/25/02 and this record is true to the best of my knowledge and belief. Kansas Water Well Contractor's Licence No. 527 This Water Well Record was completed on (mo/day/yr) 10/18/02 under the business name of GECCORE INC. by (signature) Dai Bell							
INSTRUCTIONS: Use typewriter or ball point pen. PLEASE PRESS FIRMLY and PRINT clearly. Please fill in blanks, underline or circle the correct answers. Send top three copies to Kansas Department of Health and Environment, Bureau of Water, Topeka, Kansas 66620-0001. Telephone 785-296-5524. Send one to WATER WELL OWNER and retain one for your records. Fee of \$5.00 for each constructed well.							