

1	LOCATION OF WATER WELL:	Fraction	Section Number	Township Number	Range Number
County:	SALINE	SE ¼ SE ¼ SW ¼	36	T 14 S	R 3W E/W

Distance and direction from nearest town or city street address of well if located within city?


2924 BERKLEY LANE

2 WATER WELL OWNER: DAC NGUYEN
RR#, St. Address, Box # : 2924 BERKLEY LANE
City, State, ZIP Code : SALINA, KS. 67401

Board of Agriculture, Division of Water Resources
Application Number:

3	LOCATE WELL'S LOCATION WITH	4	DEPTH OF COMPLETED WELL 60 ft. ELEVATION: 1241
---	-----------------------------	---	------------------------------------------------------------------

AN "X" IN SECTION BOX:

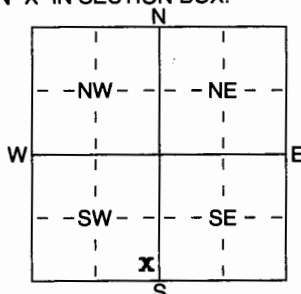

Depth(s) Groundwater Encountered 1 25 ft. 2 ft. 3 ft.
WELL'S STATIC WATER LEVEL 25 ft. below land surface measured on mo/day/yr 10-1-02
Pump test data: Well water was 29 ft. after 1 hours pumping 20 gpm
Est. Yield 7.5 gpm: Well water was ft. after hours pumping gpm
WELL WATER TO BE USED AS:

5 Public water supply	8 Air conditioning	11 Injection well
1 Domestic	3 Feedlot	6 Oil field water supply
2 Irrigation	4 Industrial	7 Domestic (lawn & garden)
		10 Monitoring well
		9 Dewatering
		12 Other (Specify below)

Was a chemical/bacteriological sample submitted to Department? Yes No**X**.....; If yes, mo/day/hrs sample was submitted
 Water Well Disinfected? Yes **X** No

5	TYPE OF BLANK CASING USED:		5 Wrought iron	8 Concrete tile	CASING JOINTS: Glued <input checked="" type="checkbox"/> Clamped	
	1 Steel	3 RMP (SR)	6 Asbestos-Cement	9 Other (specify below)		Welded
	2 PVC	4 ABS	7 Fiberglass		Threaded

Blank casing diameter 5 in. to 55 ft. Dia in. to ft. Dia in. to ft.
Casing height above land surface 16 in. weight 160 lbs./ft. Wall thickness or gauge No. SDR 26

TYPE OF SCREEN OR PERFORATION MATERIAL:			<u>7 PVC</u>	10 Asbestos-Cement
1 Steel	3 Stainless Steel	5 Fiberglass	8 RMP (SR)	11 Other (Specify)
2 Brass	4 Galvanized Steel	6 Concrete tile	9 ABS	12 None used (open hole)

SCREEN OR PERFORATION OPENINGS ARE:

1 Continuous slot	3 Mill slot <u>.025</u>	5 Guazed wrapped	8 Saw cut	11 None (open hole)
2 Louvered shutter	4 Kev punched	6 Wire wrapped	9 Drilled holes	
		7 Torch cut	10 Other (specify)	ft.

SCREEN-PERFORATED INTERVALS: From 55 ft. to 60 ft., From _____ ft. to _____ ft.
From _____ ft. to _____ ft., From _____ ft. to _____ ft.
GRAVEL PACK INTERVALS: From 23 ft. to 60 ft., From _____ ft. to _____ ft.
From _____ ft. to _____ ft., From _____ ft. to _____ ft.

6 GROUT MATERIAL: 1 Neat cement 2 Cement grout 3 Bentonite 4 Other.....
Grout Intervals: From 0 ft. to 23 ft., From ft. to ft., From ft. to ft.

What is the nearest source of possible contamination:				10 Livestock pens	14 Abandoned water well
1 Septic tank	4 Lateral lines	7 Pit privy	11 Fuel storage	15 Oil well/Gas well	
2 Sewer lines	5 Cess pool	8 Sewage lagoon	12 Fertilizer storage	16 Other (specify below)	
3 <u>Watertight sewer lines</u>	6 Seepage pit	9 Feedyard	13 Insecticide storage	
Direction from well?	EAST		How many feet?	40	

[illegible]

7] CONTRACTOR'S OR LANDOWNER'S CERTIFICATION: This water well was (1) constructed, (2) reconstructed, or (3) plugged under my jurisdiction and was completed on (mo/day/year) 10-1-02 and this record is true to the best of my knowledge and belief. Kansas Water Well Contractor's Licence No. 388 This Water Well Record was completed on (mo/day/yr) 10-1-02 under the business name of PESTINGER PUMP SERVICE by (signature) [Signature]