


2768 SCOTT AVE.

Board of Agriculture, Division of Water Resources
Application Number:

AN "X" IN SECTION BOX:

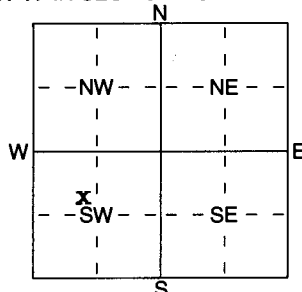

Depth(s) Groundwater Encountered 26 ft. 26 ft. 2 ft. 3-5-03 ft.
WELL'S STATIC WATER LEVEL 26 ft. below land surface measured on mo/day/yr 3-5-03
Pump test data: Well water was 29 ft. after 1 hours pumping 25 gpm
Est. Yield 75 gpm: Well water was _____ ft. after _____ hours pumping _____ gpm
WELL WATER TO BE USED AS: 5 Public water supply 8 Air conditioning 11 Injection well
1 Domestic 3 Feedlot 6 Oil field water supply 9 Dewatering 12 Other (Specify below)
2 Irrigation 4 Industrial 7 Domestic (lawn & garden) 10 Monitoring well

Was a chemical/bacteriological sample submitted to Department? Yes No X; If yes, mo/day/hrs sample was submitted X Water Well Disinfected? Yes No

5	TYPE OF BLANK CASING USED:		5 Wrought iron	8 Concrete tile	CASING JOINTS: Glued ^{XX} Clamped	
	1 Steel	3 RMP (SR)	6 Asbestos-Cement	9 Other (specify below)		Welded
	2 PVC	4 ABS	7 Fiberglass			Threaded

Blank casing diameter 5 in. to 52 ft., Dia in. to ft., Dia in. to ft.
Casing height above land surface 160 in., weight 160 lbs./ft. Wall thickness or gauge No. SDR 26

TYPE OF SCREEN OR PERFORATION MATERIAL:			<u>7 PVC</u>	10 Asbestos-Cement
1 Steel	3 Stainless Steel	5 Fiberglass	8 RMP (SR)	11 Other (Specify)
2 Brass	4 Galvanized Steel	6 Concrete tile	9 ABS	12 None used (open hole)

SCREEN OR PERFORATION OPENINGS ARE:

1 Continuous slot	3 Mill slot <u>.025</u>	5 Guazed wrapped	8 Saw cut	11 None (open hole)
2 Louvered shutter	4 Key punched	6 Wire wrapped	9 Drilled holes	
		7 Torch cut	10 Other (specify)	ft.

SCREEN-PERFORATED INTERVALS: From 52 ft. to 62 ft., From _____ ft. to _____ ft.
From _____ ft. to _____ ft., From _____ ft. to _____ ft.

GRAVEL PACK INTERVALS: From 22 ft. to 62 ft., From _____ ft. to _____ ft.
From _____ ft. to _____ ft., From _____ ft. to _____ ft.

6 GROUT MATERIAL: 1 Neat cement 2 Cement grout ~~3 Bentonite~~ 4 Other.....
Grout Intervals: From 2 ft to 20 ft. From ft. to ft. From ft. to ft.

What is the nearest source of possible contamination:			10 Livestock pens	14 Abandoned water well
1 Septic tank	4 Lateral lines	7 Pit privy	11 Fuel storage	15 Oil well/Gas well
2 Sewer lines	5 Cess pool	8 Sewage lagoon	12 Fertilizer storage	16 Other (specify below)
3 <u>Watertight sewer lines</u>	6 Seepage pit	9 Feedyard	13 Insecticide storage
Direction from well?	SOUTH		How many feet?	25

[illegible]

7] CONTRACTOR'S OR LANDOWNER'S CERTIFICATION: This water well was (1) constructed, (2) reconstructed, or (3) plugged under my jurisdiction and was completed on (mo/day/year) 5-5-03 and this record is true to the best of my knowledge and belief. Kansas Water Well Contractor's Licence No 388 This Water Well Record was completed on (mo/day/yr) 5-5-03 under the business name of PESTINGER PUMP SERVICE by (signature) [Signature]