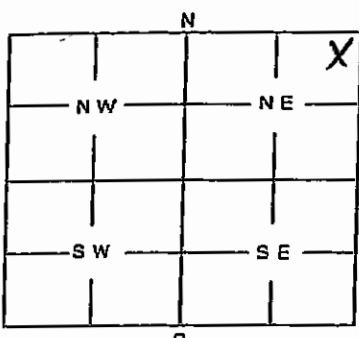


1	LOCATION OF WATER WELL:	Fraction	Section Number	Township Number	Range Number
County:	<u>SALINE</u>	<u>NE 1/4 NE 1/4 NE 1/4</u>	<u>2</u>	<u>14</u>	<u>3W</u>

Distance and direction from nearest town or city street address of well if located within city?

1745 N. 9th, SALINA, KS.

2	WATER WELL OWNER: <u>C. L. CLARK</u>	Board of Agriculture, Division of Water Resources Application Number:
RR #, St. Address, Box #:	<u>129 S. 8th</u>	
City, State, ZIP Code:	<u>SALINA, KS. 67401</u>	

3	MARK WELL'S LOCATION WITH AN "X" IN SECTION BOX:	4	DEPTH OF WELL <u>35</u> ft												
		WELL'S STATIC WATER LEVEL <u>NA</u> ft. WELL WAS USED AS: <table border="0"> <tr> <td>1 Domestic</td> <td>5 Public Water Supply</td> <td>9 Dewatering</td> </tr> <tr> <td>2 Irrigation</td> <td>6 Oil Field Water Supply</td> <td>10 Monitoring Well</td> </tr> <tr> <td>3 Feedlot</td> <td>7 Domestic (Lawn & Garden)</td> <td>11 Injection Well</td> </tr> <tr> <td>4 Industrial</td> <td>8 Air Conditioning</td> <td>12 Other</td> </tr> </table>		1 Domestic	5 Public Water Supply	9 Dewatering	2 Irrigation	6 Oil Field Water Supply	10 Monitoring Well	3 Feedlot	7 Domestic (Lawn & Garden)	11 Injection Well	4 Industrial	8 Air Conditioning	12 Other
1 Domestic	5 Public Water Supply	9 Dewatering													
2 Irrigation	6 Oil Field Water Supply	10 Monitoring Well													
3 Feedlot	7 Domestic (Lawn & Garden)	11 Injection Well													
4 Industrial	8 Air Conditioning	12 Other													
Was a chemical / bacteriological sample submitted to Department? Yes No <input checked="" type="checkbox"/> If yes, mo/day/yr sample was submitted Water Well Disinfected: Yes No <input checked="" type="checkbox"/>															

5	TYPE OF BLANK CASING USED:
1 Steel 3 RMP (SR) 5 Wrought 7 Fiberglass 9 Other (Specify below) ② PVC 4 ABS 6 Asbestos-Cement 8 Concrete Tile	
Blank casing diameter <u>2</u> in.	Was casing pulled? Yes No <input checked="" type="checkbox"/> If yes, how much
Casing height above or below land surface <u>24</u> in.	

6	GROUT PLUG MATERIAL:	1 Neat cement 2 Cement grout ③ Bentonite 4 Other
Grout Plug Intervals: From <u>0</u> ft. to <u>35</u> ft., From ft. to ft., From to ft.		
What is the nearest source of possible contamination:		
1 Septic tank 6 Seepage pit ⑪ Fuel storage 16 Other (specify below) 2 Sewer lines 7 Pit privy 12 Fertilizer storage 3 Watertight sewer lines 8 Sewage lagoon 13 Insecticide storage 4 Lateral lines 9 Feedyard 14 Abandoned water well 5 Cess Pool 10 Livestock pens 15 Oil well/Gas well		
Direction from well? <u>NE</u> How many feet? <u>150'</u>		

FROM	TO	PLUGGING MATERIALS
<u>0</u>	<u>3</u>	<u>BENTONITE</u>
<u>3</u>	<u>35</u>	<u>BENTONITE</u>

MW6
(CAMPER CENTER)

7	CONTRACTOR'S OR LANDOWNER'S CERTIFICATION: This water well was plugged under my jurisdiction and was completed on (mo/day/year) <u>5/19/03</u> and this record is true to the best of my knowledge and belief. Kansas Water Well Contractor's License No. <u>527</u> This Water Well Record was completed on (mo/day/year) <u>5/29/03</u> under the business name of <u>GEDCOKE INC.</u> by (signature) <u>[Signature]</u>
---	---

INSTRUCTIONS: Use typewriter or ball point pen. Please press firmly and print clearly. Please fill in blanks, underline or circle the correct answers. Send top three copies to Kansas Department of Health and Environment, Bureau of Water, Topeka, Kansas 66620-0001. Telephone: 785/296-3565. Send one to Water Well Owner and retain one for your records.