


[illegible]

Sailina Shop
8-27-03

Not To Scale

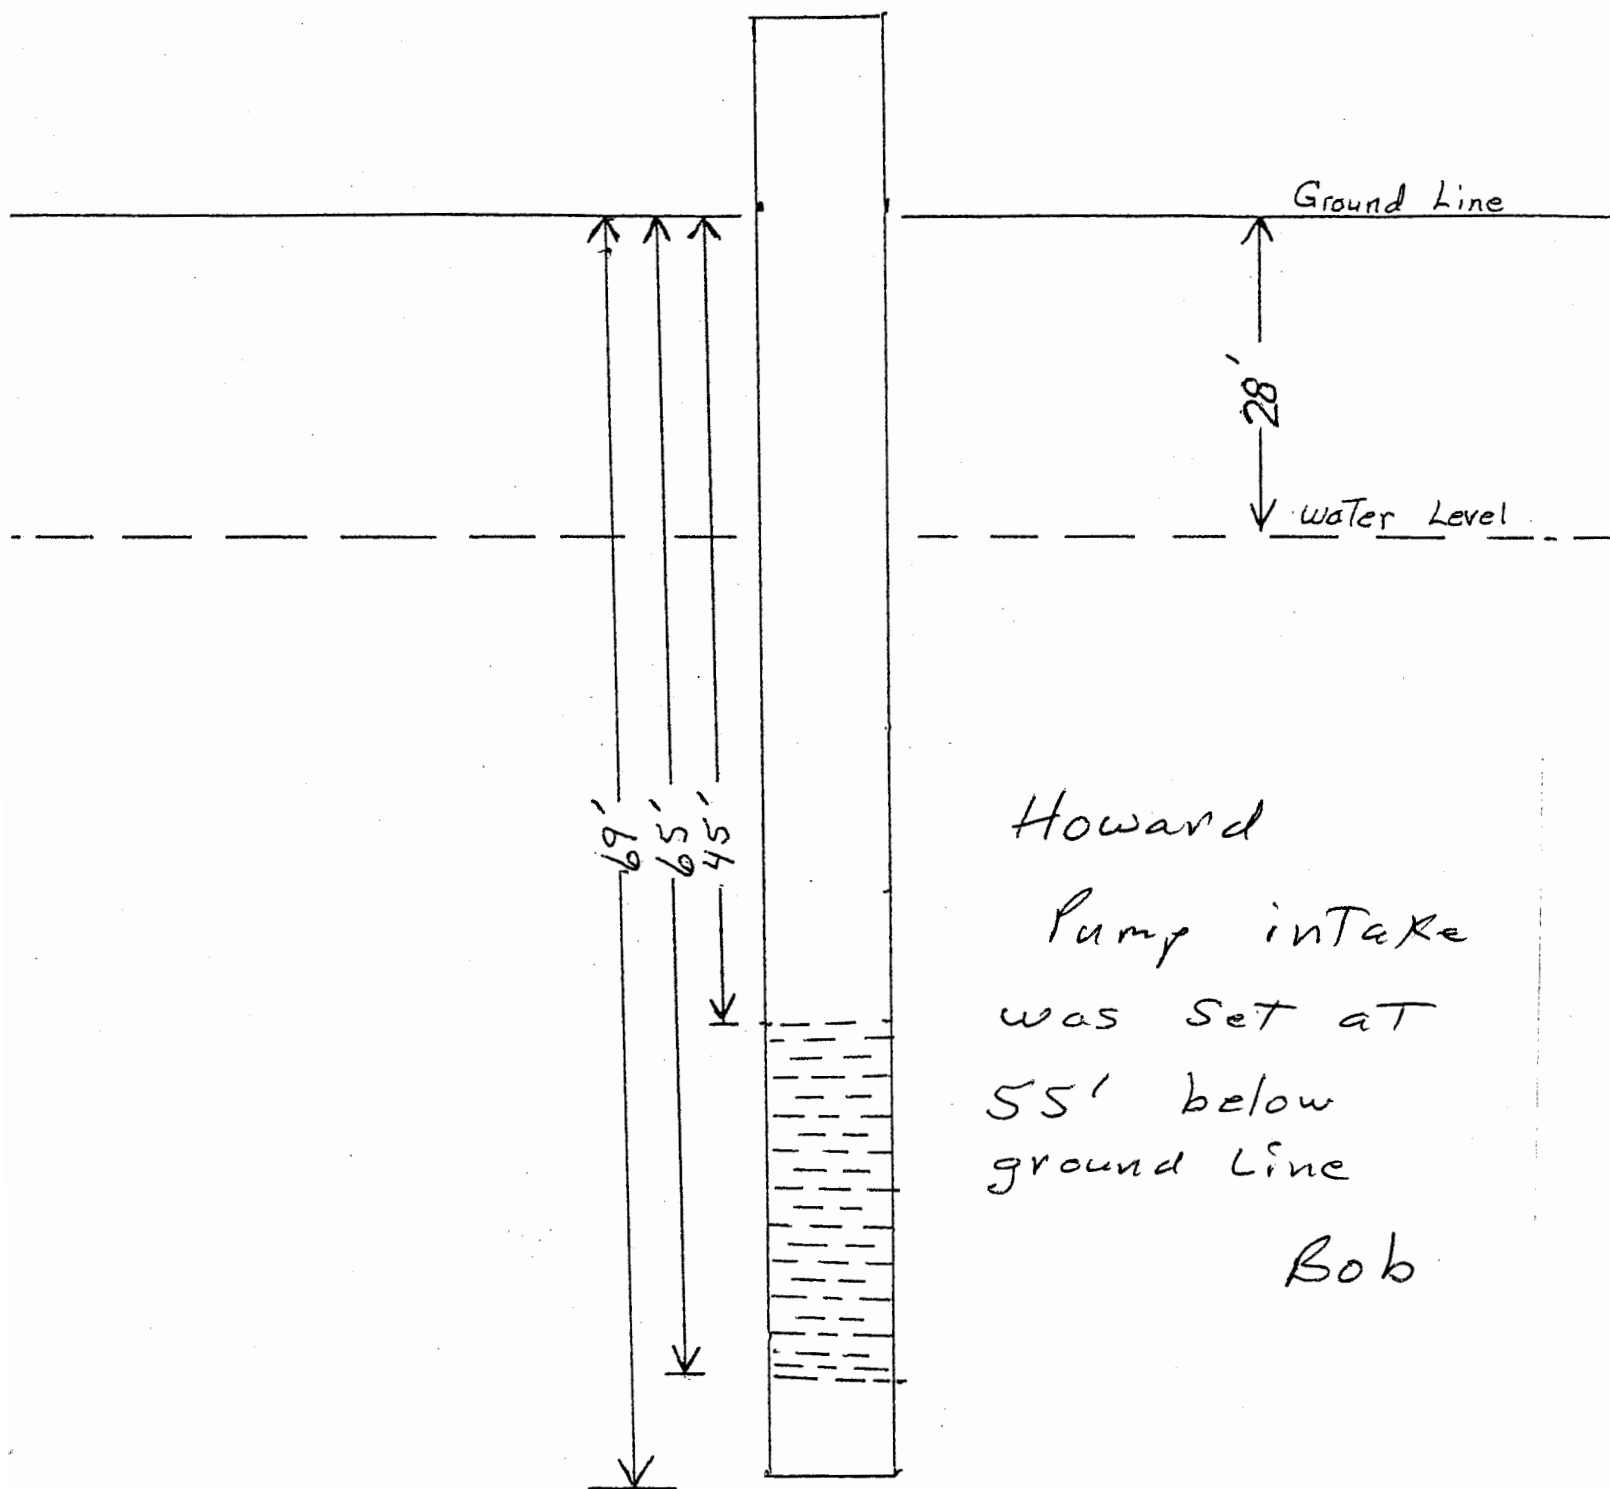

Howard
Pump intake
was set at
55' below
ground line
Bob

Pump test 9/2/03 Bergman, Donley, Croxton

Start 3:00 static water level @ 28.3' below surface
pump placed at 55'

3:00 5 gal/min

3:05 W.L. stable @ 30.8'

3:30 go to 10 gal/min

3:35 W.L. stable @ 31.6'

4:00 stop for day

9/3/03 static W.L. @ 28.3'

8:35 go to 15 gal/min

9:25 W.L. stable @ 35.0'

9:30 go to 20 gal/min

10:45 W.L. down to 46.5'

10:55 W.L. raised to 44.7'

11:05 W.L. back down to 46.7'

11:10 W.L. raised back to ~~45~~ 45.7', stopped test
still bringing up clay, some silt and fine sand;
cleaner than at start of test.

Howard, we pumped 20 gal/min for over an hour and a half. I'd consider buying a shutoff switch for if the water ~~by~~ dropped below about 52'. Water is taking its time clearing up - you may need to run in a while. Good luck. N. Croxton