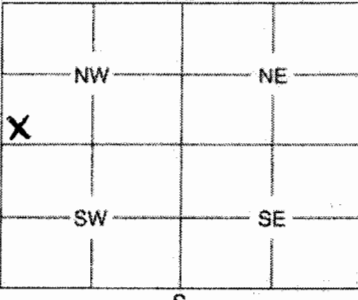


1	LOCATION OF WATER WELL: Saline	Fraction SW $\frac{1}{4}$ SW $\frac{1}{4}$ NW $\frac{1}{4}$	Section Number 11	Township Number 14S	Range Number 3	EW
---	--	--	-----------------------------	-------------------------------	--------------------------	-----------

Distance and direction from nearest town or city street address of well if located within city?

W. North Street Road, Salina, KS

2	WATER WELL OWNER: UPS c/o KDHE Time and Materials	
	RR #, St. Address, Box #: 1000 SW Jackson #410	Board of Agriculture, Division of Water Resources
	City, State, ZIP Code : Topeka, Ks. 66612-1367	Application Number:

3	MARK WELL'S LOCATION WITH AN "X" IN SECTION BOX: 	4	DEPTH OF WELL 22.02 ft. WELL'S STATIC WATER LEVEL 19.49 ft. WELL WAS USED AS: <table border="0"> <tr> <td>1 Domestic</td> <td>5 Public Water Supply</td> <td>9 Dewatering</td> </tr> <tr> <td>2 Irrigation</td> <td>6 Oil Field Water Supply</td> <td>10 Monitoring Well</td> </tr> <tr> <td>3 Feedlot</td> <td>7 Domestic (Lawn & Garden)</td> <td>11 Injection Well</td> </tr> <tr> <td>4 Industrial</td> <td>8 Air Conditioning</td> <td>12 Other</td> </tr> </table>	1 Domestic	5 Public Water Supply	9 Dewatering	2 Irrigation	6 Oil Field Water Supply	10 Monitoring Well	3 Feedlot	7 Domestic (Lawn & Garden)	11 Injection Well	4 Industrial	8 Air Conditioning	12 Other
1 Domestic	5 Public Water Supply	9 Dewatering													
2 Irrigation	6 Oil Field Water Supply	10 Monitoring Well													
3 Feedlot	7 Domestic (Lawn & Garden)	11 Injection Well													
4 Industrial	8 Air Conditioning	12 Other													

Was a chemical / bacteriological sample submitted to Department? Yes No **X**

If yes, mo/day/yr sample was submitted

Water Well Disinfected: Yes No **X**

5	TYPE OF BLANK CASING USED:	
	1 Steel 2 PVC 3 RMP (SR) 4 ABS 5 Wrought 6 Asbestos-Cement 7 Fiberglass 8 Concrete Tile 9 Other (Specify below)	
	Blank casing diameter 2 in.	Was casing pulled? Yes X No
	Casing height above or below land surface	If yes, how much 20'

6	GROUT PLUG MATERIAL:	
	1 Neat cement 2 Cement grout 3 Bentonite 4 Other Surface silts and clays	
	Grout Plug Intervals: From 20' ft. to 3 ft.	From 4 ft. to 0 ft. From to ft.
	What is the nearest source of possible contamination:	
	1 Septic tank 2 Sewer lines 3 Watertight sewer lines 4 Lateral lines 5 Cess pool 6 Seepage pit 7 Pit privy 8 Sewage lagoon 9 Feedyard 10 Livestock pens 11 Fuel storage 12 Fertilizer storage 13 Insecticide storage 14 Abandoned water well 15 Oil well/Gas well 16 Other (specify below)	
	Direction from well?	How many feet?

FROM	TO	PLUGGING MATERIALS
0	3	Surface Silt and Clays
20	3	Bentonite

RECEIVED

SEP 09 2004

BUREAU OF WATER

7	CONTRACTOR'S OF LANDOWNER'S CERTIFICATION: This water well was plugged under my jurisdiction and was completed on (mo/day/year) 08/23/04 and this record is true to the best of my knowledge and belief. Kansas Water Well Contractor's License No. 585 This Water Well Record was completed on (mo/day/year) 08/30/04 under the business name of Associated Environmental, Inc. by (signature) Darin Duncan	
---	--	--

INSTRUCTIONS: Use typewriter or ball point pen. Please press firmly and print clearly. Please fill in blanks, underline or circle the correct answers. Send top three copies to Kansas Department of Health and Environment, Bureau of Water, Geology Section, 1000 SW Jackson St., Ste. 420, Topeka, Kansas 66612-1367. Telephone: 785/296-5522. Send one to Water Well Owner and retain one for your records.