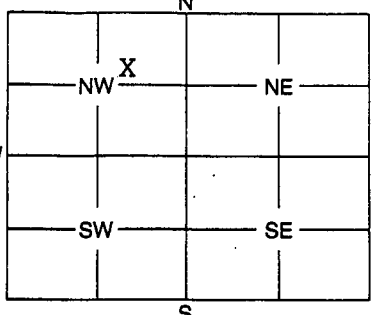


1	LOCATION OF WATER WELL:	Fraction	Section	Number	Township	Number	Range	Number																				
	County: Saline	SW 1/4 NE 1/4 NW 1/4		13		14	3	EW																				
Distance and direction from nearest town or city street address of well if located within city? 307 E. Walnut, Salina																												
2	WATER WELL OWNER: Delmer Sherbert RR #, St. Address, Box #: 618 E. Republic City, State, ZIP Code : Salina, KS 67401 Board of Agriculture, Division of Water Resources Application Number:																											
3	MARK WELL'S LOCATION WITH AN "X" IN SECTION BOX:		4 DEPTH OF WELL 50 ft. WELL'S STATIC WATER LEVEL Unk. ft. WELL WAS USED AS: 1 Domestic 5 Public Water Supply 9 Dewatering 2 Irrigation 6 Oil Field Water Supply 10 Monitoring Well 3 Feedlot 7 Domestic (Lawn & Garden) 11 Injection Well 4 Industrial 8 Air Conditioning 12 Other Air sparge																									
			Was a chemical / bacteriological sample submitted to Department? Yes No X If yes, mo/day/yr sample was submitted Water Well Disinfected: Yes No X																									
5	TYPE OF BLANK CASING USED: 1 Steel 3 RMP (SR) 5 Wrought 7 Fiberglass 9 Other (Specify below) 2 PVC 4 ABS 6 Asbestos-Cement 8 Concrete Tile Blank casing diameter 2 in. Was casing pulled? Yes X No Casing height above or below land surface n/a in. Drilled out to 20'																											
6	GROUT PLUG MATERIAL: 1 Neat cement 2 Cement grout 3 Bentonite 4 Other Grout Plug Intervals: From 0 ft. to 1 ft., From 1 ft. to 50 ft., From to What is the nearest source of possible contamination: 1 Septic tank 6 Seepage pit 11 Fuel storage 16 Other (specify below) 2 Sewer lines 7 Pit privy 12 Fertilizer storage 3 Watertight sewer lines 8 Sewage lagoon 13 Insecticide storage 4 Lateral lines 9 Feedyard 14 Abandoned water well 5 Cess pool 10 Livestock pens 15 Oil well/Gas well Direction from well? on site How many feet?																											
<table border="1"><thead><tr><th>FROM</th><th>TO</th><th>PLUGGING MATERIALS</th></tr></thead><tbody><tr><td>0</td><td>1</td><td>Cement grout</td></tr><tr><td>1</td><td>20</td><td>Bentonite (8")</td></tr><tr><td>20</td><td>50</td><td>Bentonite (2")</td></tr><tr><td></td><td></td><td></td></tr><tr><td></td><td></td><td></td></tr><tr><td></td><td></td><td></td></tr></tbody></table>			FROM	TO	PLUGGING MATERIALS	0	1	Cement grout	1	20	Bentonite (8")	20	50	Bentonite (2")										AS 1  GeoCore #967				
FROM	TO	PLUGGING MATERIALS																										
0	1	Cement grout																										
1	20	Bentonite (8")																										
20	50	Bentonite (2")																										
7	CONTRACTOR'S OF LANDOWNER'S CERTIFICATION: This water well was plugged under my jurisdiction and was completed on (mo/day/year) 12/29/2004 and this record is true to the best of my knowledge and belief. Kansas Water Well Contractor's License No. 527 This Water Well Record was completed on (mo/day/year) 1/4/2005 under the business name of GeoCore Inc. by (signature) One Rel																											
INSTRUCTIONS: Use typewriter or ball point pen. Please press firmly and print clearly. Please fill in blanks, underline or circle the correct answers. Send top three copies to Kansas Department of Health and Environment, Bureau of Water, Geology Section, 1000 SW Jackson St., Ste. 420, Topeka, Kansas 66612-1367. Telephone: 785/296-5522. Send one to Water Well Owner and retain one for your records.																												