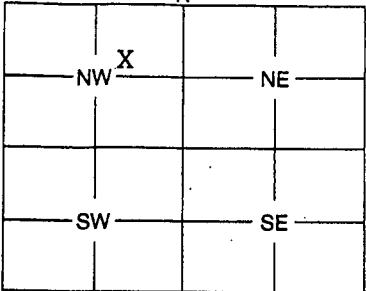


1	LOCATION OF WATER WELL:	Fraction	Section Number	Township Number	Range Number
	County: <u>Saline</u>	<u>SW 1/4 NE 1/4 NW 1/4</u>	<u>13</u>	<u>14</u>	<u>3</u> EW
Distance and direction from nearest town or city street address of well if located within city? <u>307 E. Walnut, Salina</u>					

2	WATER WELL OWNER: <u>Delmer Sherbert</u> RR #, St. Address, Box #: <u>618 E. Republic</u> City, State, ZIP Code: <u>Salina, KS 67401</u>	Board of Agriculture, Division of Water Resources Application Number:
---	--	--

3	MARK WELL'S LOCATION WITH AN "X" IN SECTION BOX: 	4	DEPTH OF WELL <u>54</u> ft. WELL'S STATIC WATER LEVEL <u>Unk</u> ft. WELL WAS USED AS: 1 Domestic 2 Irrigation 3 Feedlot 4 Industrial 5 Public Water Supply 6 Oil Field Water Supply 7 Domestic (Lawn & Garden) 8 Air Conditioning 9 Dewatering 10 Monitoring Well 11 Injection Well 12 <u>Other</u> <u>Air sparge</u> Was a chemical / bacteriological sample submitted to Department? Yes No <u>X</u> If yes, mo/day/yr sample was submitted Water Well Disinfected: Yes No <u>X</u>
---	--	---	---

5	TYPE OF BLANK CASING USED: 1 Steel 2 <u>PVC</u> 3 RMP (SR) 4 ABS 5 Wrought 6 Asbestos-Cement 7 Fiberglass 8 Concrete Tile 9 Other (Specify below) _____ Blank casing diameter <u>2</u> in. Was casing pulled? Yes <u>X</u> No Casing height above or below land surface <u>n/a</u> in. <u>Drilled out to 20'</u> If yes, how much
---	---

6	GROUT PLUG MATERIAL: 1 Neat cement 2 <u>Cement grout</u> 3 <u>Bentonite</u> 4 Other Grout Plug Intervals: From <u>0</u> ft. to <u>1</u> ft., From <u>1</u> ft. to <u>54</u> ft., From to ft. What is the nearest source of possible contamination: 1 Septic tank 6 Seepage pit 11 <u>Fuel storage</u> 16 Other (specify below) 2 Sewer lines 7 Pit privy 12 Fertilizer storage 3 Watertight sewer lines 8 Sewage lagoon 13 Insecticide storage 4 Lateral lines 9 Feedyard 14 Abandoned water well 5 Cess pool 10 Livestock pens 15 Oil well/Gas well Direction from well? <u>on site</u> How many feet?
---	---

FROM	TO	PLUGGING MATERIALS
0	1	<u>Cement grout</u>
1	20	<u>Bentonite (8")</u>
20	54	<u>Bentonite (2")</u>

AS 4

GeoCore #967

7	CONTRACTOR'S OF LANDOWNER'S CERTIFICATION: This water well was plugged under my jurisdiction and was completed on (mo/day/year) <u>12/29/2004</u> and this record is true to the best of my knowledge and belief. Kansas Water Well Contractor's License No. <u>527</u> This Water Well Record was completed on (mo/day/year) <u>1/4/2005</u> under the business name of <u>GeoCore Inc.</u> by (signature) <u>Delmer Sherbert</u>
---	---

INSTRUCTIONS: Use typewriter or ball point pen. Please press firmly and print clearly. Please fill in blanks, underline or circle the correct answers. Send top three copies to Kansas Department of Health and Environment, Bureau of Water, Geology Section, 1000 SW Jackson St. Ste. 420 Topeka, Kansas 66612-1367 Telephone: 785/296-5522 Send one to Water Well Owner and retain one for your records.