



5054246

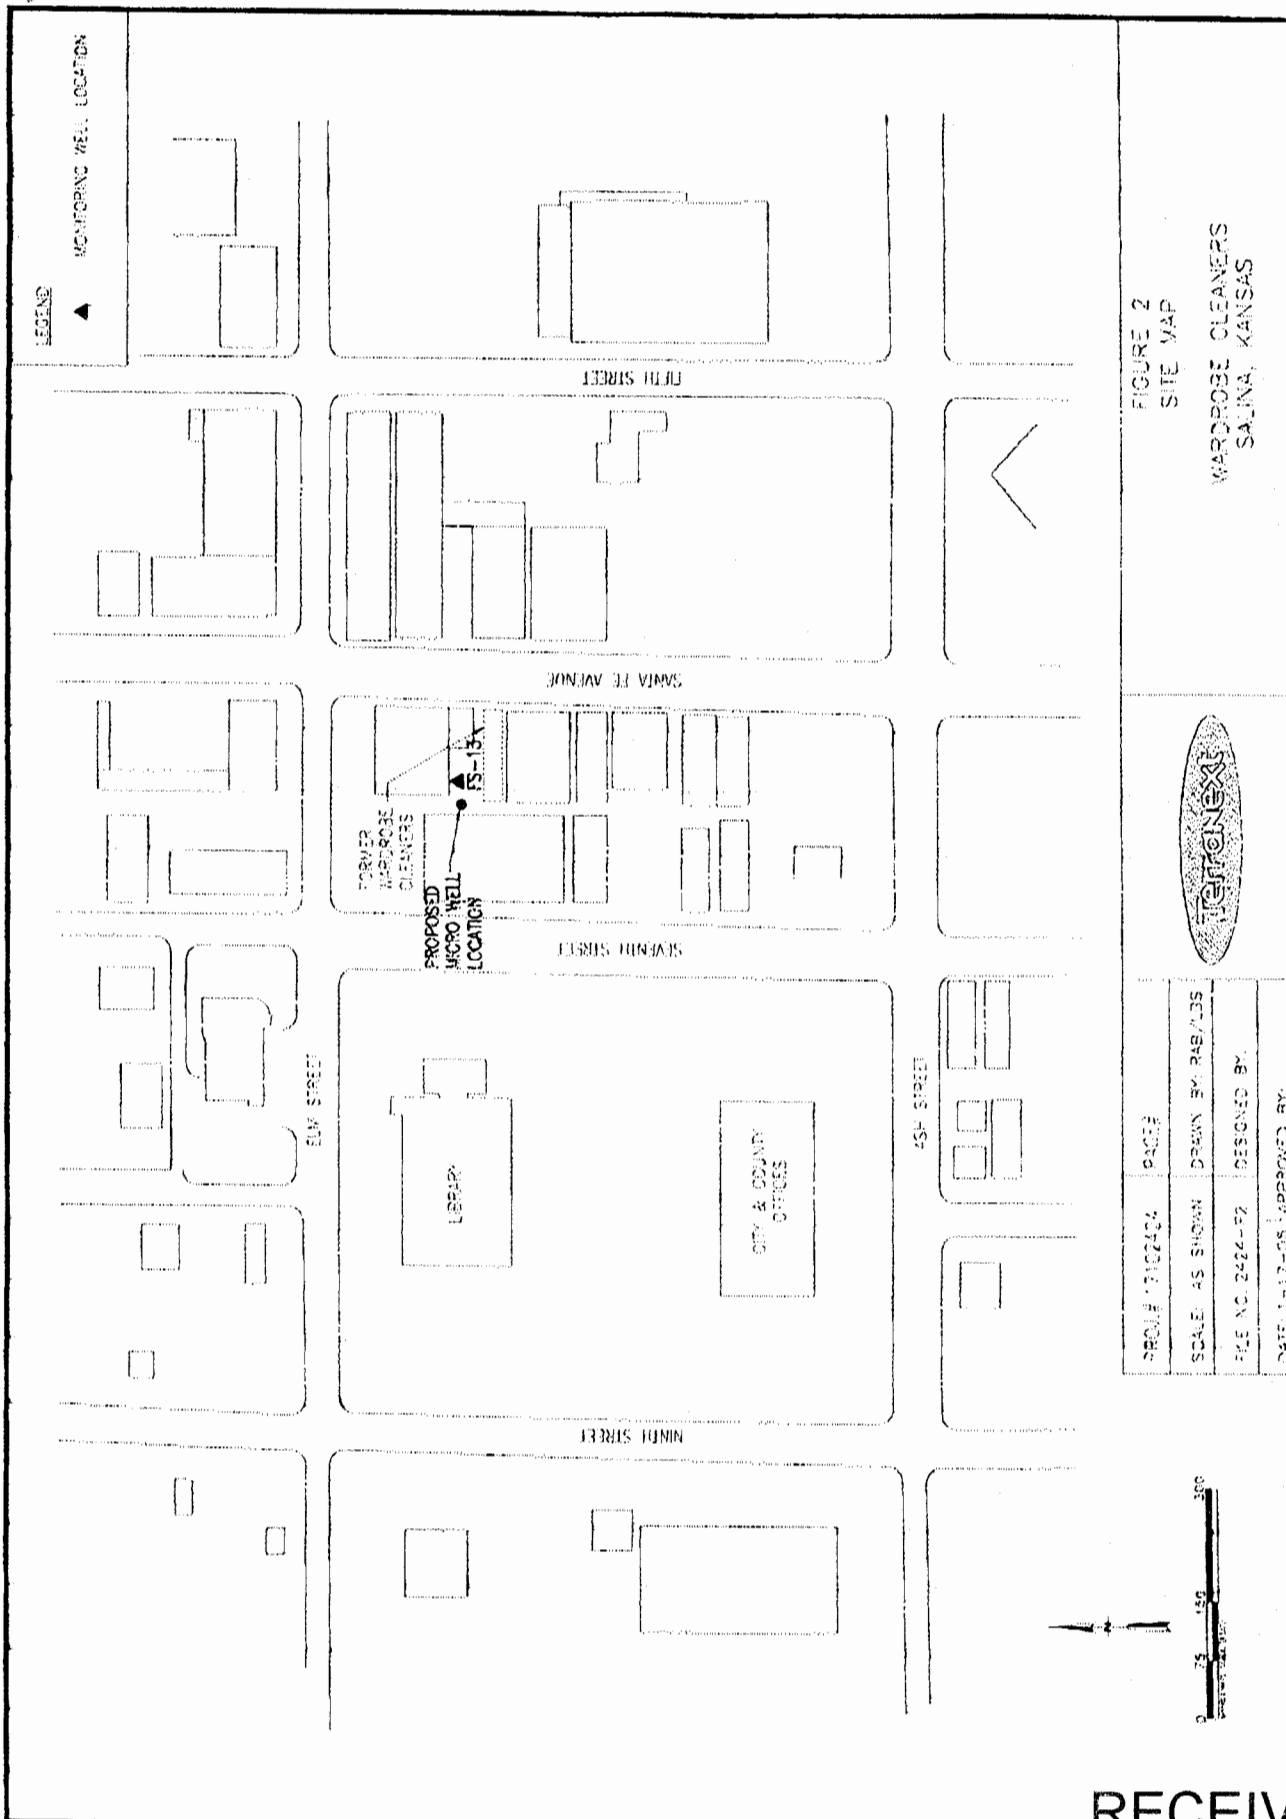


FIGURE 2  
SITE MAP  
WARDROBE CLEANERS  
SALINA, KANSAS



PROJECT 7102424	PAGE 2
SCALE AS SHOWN	DRAWN BY: RAB/JDS
FILE NO: 2424-72	DESIGNED BY:
DATE: 1-17-05	APPROVED BY:

RECEIVED  
MAR 09 2005  
BUREAU OF WATER