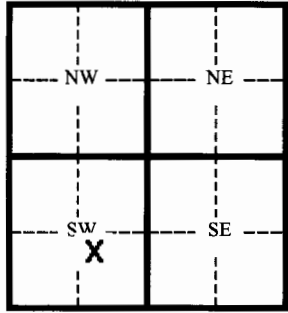


1	LOCATION OF WATER WELL:	Fraction	Section Number	Township Number	Range Number
County:	Saline	NW 1/4 SE 1/4 SW 1/4	14	14	3-West

Distance and direction from nearest town or city street address of well if located within city?

1315 Beverly Drive, Salina, Kansas

2	WATER WELL OWNER: Ott Oil Company, Inc.	Board of Agriculture, Division of Water Resources Application Number:
RR#, St. Address, Box #	1315 Beverly Drive	
City, State, ZIP Code	Salina, Kansas 67401	

3	MARK WELL'S LOCATION WITH AN "X" IN SECTION BOX:	4	DEPTH OF WELL 35.0 ft.												
		WELL'S STATIC WATER LEVEL 25.95 ft.													
		WELL WAS USED AS:													
		<table><tr><td>1 Domestic</td><td>5 Public Water Supply</td><td>9 Dewatering</td></tr><tr><td>2 Irrigation</td><td>6 Oil Field Water Supply</td><td>10 Monitoring Well</td></tr><tr><td>3 Feedlot</td><td>7 Lawn and Garden (domestic)</td><td>11 Injection Well</td></tr><tr><td>4 Industrial</td><td>8 Air Conditioning</td><td>12 Other</td></tr>
Was a chemical/bacteriological sample submitted to Department? Yes ___ No X															
If yes, mo/day/yr sample was submitted _____		Water Well Disinfected: Yes ___ No X													


5	TYPE OF BLANK CASING USED:	Blank casing diameter 2.375 in.		Was casing pulled? Yes X No ___	If yes, how much? 35.0'
1 Steel 3 RMP (SR) 5 Wrought 7 Fiberglass 9 Other (specify below)					
2 PVC 4 ABC 6 Asbestos-Cement 8 Concrete Tile					
Casing height above or below land surface Unknown in.		Well overdrilled to 20'			

6	GROUT PLUG MATERIAL: 1 Neat cement 2 Cement grout 3 Bentonite 4 Other Soils
Grout Plug Intervals From 20.0 ft. to 1.0 ft. From 1.0 ft. to 0.0 ft. From ___ ft. to ___ ft.	
What is the nearest source of possible contamination:	

- | | | | |
|--------------------------|-------------------|-------------------------|--------------------------|
| 1 Septic tank | 6 Seepage pit | 11 Fuel storage | 16 Other (specify below) |
| 2 Sewer lines | 7 Pit privy | 12 Fertilizer storage | |
| 3 Watertight sewer lines | 8 Sewage lagoon | 13 Insecticide storage | |
| 4 Lateral lines | 9 Feedyard | 14 Abandoned water well | |
| 5 Cess Pool | 10 Livestock pens | 15 Oil well/ Gas well | |

Direction from well? **Southwest** How many feet? **120**

FROM	TO	CODE	PLUGGING MATERIALS
0.0	1.0		Compacted soils
1.0	20.0		Bentonite chips

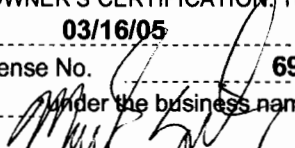7	CONTRACTOR'S OR LANDOWNER'S CERTIFICATION: This water well was plugged under my jurisdiction and was completed on (mo/day/yr) 03/16/05 and this record is true to the best of my knowledge and belief. Kansas Water Well Contractor's License No. 692 This Water Well Record was completed on (mo/day/yr) 04/04/05 under the business name of Quad State Services, Inc. by (signature) 	
---	--	--

INSTRUCTIONS: Please fill in blanks and circle the correct answers. Send three copies to Kansas Department of Health and Environment, Bureau of Water, 1000 S W Jackson St., Ste. 420, Topeka, Kansas 66620-0001. Telephone: 785-296-3565. Send one to Water Well Owner and retain one for your records.