

WATER WELL RECORD Form WWC-5 KSA 82a-1212 ID No. \_\_\_\_\_


1 LOCATION OF WATER WELL:		Fraction	Section Number	Township Number	Range Number
County: <b>Saline</b>		<b>SE</b> $\frac{1}{4}$ <b>SW</b> $\frac{1}{4}$ <b>NW</b> $\frac{1}{4}$	<b>12</b>	<b>T 14 S</b>	<b>R 03 W</b>
Distance and direction from nearest town or city street address of well if located within city? <b>501 N. Santa Fe Street, Salina</b>					
2 WATER WELL OWNER:		KDHE			
RR#, St. Address, Box # :		<b>1000 SW Jackson Ste. 410</b>			
City, State, ZIP Code :		<b>Topeka, KS 66612</b>			
Board of Agriculture, Division of Water Resources		Application Number:			
3 LOCATE WELL'S LOCATION WITH AN "X" IN SECTION BOX:		4 DEPTH OF COMPLETED WELL			
		AS-50 SVE-30 Prod-40 ft. ELEVATION: _____			
		Depth(s) Groundwater Encountered 1 <b>36</b> ft. 2 _____ ft. 3 _____ ft.			
		WELL'S STATIC WATER LEVEL _____ ft. below land surface measured on mo/day/yr			
		Pump test data: Well water was _____ ft. after _____ hours pumping _____ gpm			
		Est. Yield _____ gpm: Well water was _____ ft. after _____ hours pumping _____ gpm			
Bore Hole Diameter <b>5 ft</b> in. to <b>40 (SVE &amp; Prod)</b> ft. and <b>8.5 in</b> in. to <b>40-50 (AS)</b> ft.		WELL WATER TO BE USED AS: 5 Public water supply 8 Air conditioning 11 Injection well			
1 Domestic 3 Feed lot 6 Oil field water supply 9 Dewatering		12 Other (Specify below) Soil Vapor Extraction (SVE) Air Sparge (AS) Product Recovery (Prod)			
2 Irrigation 4 Industrial 7 Lawn and garden (domestic) 10 Monitoring well		Was a chemical/bacteriological sample submitted to Department? Yes _____ No <b>X</b> If yes, mo/day/yr sample was submitted			
Water Well Disinfected? Yes _____ No <b>X</b>					
5 TYPE OF BLANK CASING USED:					
1 Steel 3 RMP (SR) 5 Wrought Iron 8 Concrete tile		CASING JOINTS: Glued _____ Clamped _____			
2 PVC 4 ABS 6 Asbestos-Cement 9 Other (specify below)		Welded _____			
7 Fiberglass		Threaded _____ Flush _____			
Blank casing diameter <b>2 (AS)</b> in. to <b>48 (AS)</b> ft., Dia <b>4 (SVE)</b> in. to <b>10 (SVE)</b> ft., Dia <b>4 (Prod)</b> in. to <b>20 (Prod)</b> ft.					
Casing height above land surface <b>Flushmount</b> in., weight <b>2.0 (SVE &amp; Prod)</b> lbs./ft. Wall thickness or gauge No. <b>Sch. 40</b>					
TYPE OF SCREEN OR PERFORATION MATERIAL:					
1 Steel 3 Stainless steel 5 Fiberglass 8 RMP (SR) 11 Other (specify) _____		7 PVC 10 Asbestos-cement			
2 Brass 4 Galvanized steel 6 Concrete tile 9 ABS 12 None used (open hole)					
SCREEN OR PERFORATION OPENINGS ARE:					
1 Continuous slot 3 Mill slot 5 Gauzed wrapped 8 Saw cut 11 None (open hole)		6 Wire wrapped 9 Drilled holes 10 Other (specify) _____			
2 Louvered shutter 4 Key punched 7 Torch cut					
SCREEN-PERFORATED INTERVALS: From <b>48 (AS)</b> ft. to <b>50 (AS)</b> ft. From <b>10 (SVE)</b> ft. to <b>30 (SVE)</b> ft.					
From <b>20 (Prod)</b> ft. to <b>40 (Prod)</b> ft. From _____ ft. to _____ ft.					
GRAVEL PACK INTERVALS: From <b>7</b> ft. to <b>40 (SVE &amp; Prod)</b>					
From <b>38</b> ft. to <b>50 (AS)</b>					
6 GROUT MATERIAL:					
1 Neat cement 2 Cement grout 3 Bentonite 4 Other _____					
Grout Intervals From <b>0 (1)</b> ft. to <b>0.5 (1)</b> ft. From <b>5 (1)</b> ft. to <b>7 (1)</b> ft. From <b>AS-0 (1)</b> ft. to <b>AS-32 (1)</b> ft.					
What is the nearest source of possible contamination:					
1 Septic tank 4 Lateral lines 7 Pit privy 10 Livestock pens 14 Abandoned water well		11 Fuel storage 15 Oil well/ Gas well			
2 Sewer lines 5 Cess pool 8 Sewage lagoon 12 Fertilizer storage 16 Other (specify below)		3 Watertight sewer lines 6 Seepage pit 9 Feedyard 13 Insecticide storage			
Direction from well? _____ How many feet? _____					
FROM	TO	CODE	LITHOLOGIC LOG	FROM	TO
0	4	CL	Back Fill/Clay, soft to firm, low to mod. plast		
4	27	CL	Clay, silty, low to mod plasticity, sandstone/ limestone 8"-36" dia. & 2'-6' dia. @ 16'-27'		
27	36	CL	Clay, silty, firm to stiff, mod to high plasticity		
36	37	CL	Clay, silty, trace med.-coarse sand		
37	41	SP	Sand, fine-coarse grain, poorly sorted		
41	44	CL	Clay, silty, soft to firm, low to mod plasticity		
44	45	SP	Sand, very fine to med grain, mod. sorted		
45	46	CL	Clay, silty, soft to firm low to mod plasticity		
46	50	SP	Sand, very fine to med. grain, mod. sorted		
7 CONTRACTOR'S OR LANDOWNER'S CERTIFICATION: This water well was <b>(1) constructed</b> , (2) reconstructed, or (3) plugged under my jurisdiction and was completed on (mo/day/yr) <b>11-1-05</b> and this record is true to the best of my knowledge and belief. Kansas					
Water Well Contractor's License No. <b>531</b> This Water Well Record was completed on (mo/day/yr) <b>11-1-05</b>					
under the business name of <b>Geotechnical Services, Inc.</b> by (signature) _____					
INSTRUCTIONS: Please fill in blanks and circle the correct answers. Send three copies to Kansas Department of Health and Environment, Bureau of Water, 1000 S W Jackson St., Ste. 420, Topeka, Kansas 66612-1367. Telephone: 913-296-5545. Send one to WATER WELL OWNER and retain one for your records.					

OFFICE USE ONLY

T

R

SEC

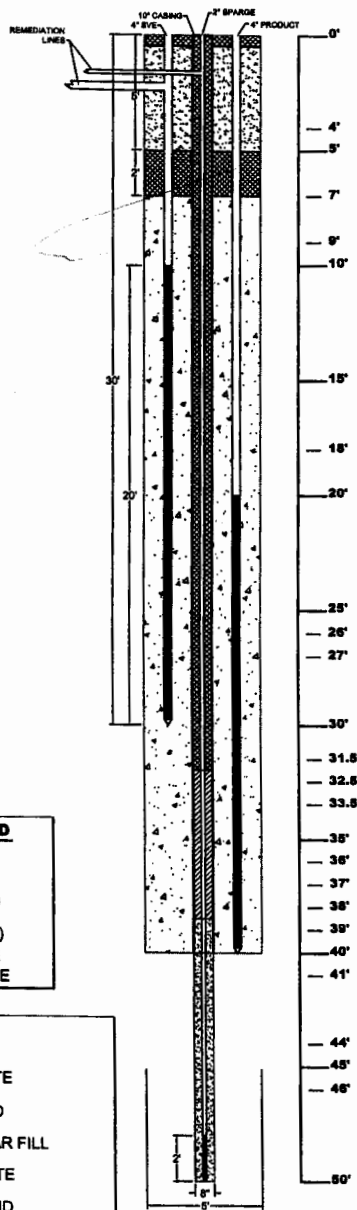

### LITHOLOGY LEGEND

- = BACKFILL
- = CLAY (CL)
- = SAND (SP)
- (A) = AIR SAMPLE
- (S) = SOIL SAMPLE

### WELL LEGEND

- = CONCRETE
- = FILL SAND
- = GRANULAR FILL
- = BENTONITE
- = 12-20 SAND

### PID LITHOLOGY

0 (A)	BACKFILL/ CLAY(CL) - dark brown, soft to firm, low to moderate plasticity, damp
4.8 (A)	CLAY(CL) - light brown, silty, low to moderate plasticity, soft to firm, damp, sandstone/limestone 8"- 36" diameter
11.8 (A) 84 (S)	CLAY(CL) - light brown, very silty, low to moderate plasticity, soft to firm, moist, sandstone/limestone 2"- 8" diameter
3.3 (A)	
20 (A)	CLAY(CL) - light green, silty firm to stiff, moderate to high plasticity, moist
136 (S) 50 (A) 33 (A)	
33 (A)	CLAY(CL) - dark gray, silty, trace medium to coarse grained sand, saturated
50 (A) 150 (A) 30 (A)	SAND(SP) - dark gray, fine to coarse grained, poorly sorted, saturated
	CLAY(CL) - gray, silty, soft to firm, low to moderate plasticity, saturated
44'	
45'	SAND(SP) - gray- brown, very fine to medium grained, moderately sorted, saturated
46'	CLAY(CL) - gray, silty, soft to firm, low to moderate plasticity, saturated
	SAND(SP) - gray to light brown, very fine to medium grained, moderately sorted, saturated

TOTAL DEPTH 50 FEET

### SVE DETAILS

<b>ELEVATION</b>	<b>RISER</b>
CASING: _____	TYPE: PVC
PAD: _____	SCHEDULE: 40
<b>PROTECTIVE COVER</b>	INSIDE DIA: 4"
TYPE: MANHOLE	LENGTH: 12'
SIZE: 18"	<b>SCREEN</b>
PAD SIZE: NA	TYPE: PVC
<b>WELL SEAL</b>	SCHEDULE: 40
TYPE: CONCRETE	SLOT: 0.010
AMOUNT: NA	INSIDE DIA: 4"
WATER: NA	LENGTH: 20'
<b>WELL PACK</b>	<b>END CAP</b>
TYPE: ROAD GRAVEL	TYPE: SLIP
AMOUNT: NA	LENGTH: NA
WATER: NA	<b>WATER LEVEL OBSERVATIONS</b>
	WHILE DRILLING: 36"
	END OF DRILLING: NA
	DATE DRILLED: 10/20/05
	DRILLER: MO-KAN
	GEOLOGIST: D. ROY
	DRILL METHOD: LARGE DIA. BORING

### AS DETAILS

<b>ELEVATION</b>	<b>RISER</b>
CASING: _____	TYPE: PVC
PAD: _____	SCHEDULE: 40
<b>PROTECTIVE COVER</b>	INSIDE DIA: 4"
TYPE: MANHOLE	LENGTH: 12'
SIZE: 18"	<b>SCREEN</b>
PAD SIZE: NA	TYPE: PVC
<b>WELL SEAL</b>	SCHEDULE: 40
TYPE: CONCRETE/BENTONITE	SLOT: 0.010
AMOUNT: NA	INSIDE DIA: 4"
WATER: NA	LENGTH: 20'
<b>WELL PACK</b>	<b>END CAP</b>
TYPE: ROAD GRAVEL	TYPE: SLIP
AMOUNT: 150 lbs.	LENGTH: NA
WATER: NA	<b>WATER LEVEL OBSERVATIONS</b>
	WHILE DRILLING: 36"
	END OF DRILLING: NA
	DATE DRILLED: 11/14/05
	DRILLER: D. ROY
	GEOLOGIST: D. ROY
	DRILL METHOD: 4.25" MO-KAN STAIN AUGER

### PRODUCT DETAILS

<b>ELEVATION</b>	<b>RISER</b>
CASING: _____	TYPE: PVC
PAD: _____	SCHEDULE: 40
<b>PROTECTIVE COVER</b>	INSIDE DIA: 4"
TYPE: MANHOLE	LENGTH: 12'
SIZE: 18"	<b>SCREEN</b>
PAD SIZE: NA	TYPE: PVC
<b>WELL SEAL</b>	SCHEDULE: 40
TYPE: CONCRETE	SLOT: 0.010
AMOUNT: NA	INSIDE DIA: 4"
WATER: NA	LENGTH: 20'
<b>WELL PACK</b>	<b>END CAP</b>
TYPE: ROAD GRAVEL	TYPE: SLIP
AMOUNT: NA	LENGTH: NA
WATER: NA	<b>WATER LEVEL OBSERVATIONS</b>
	WHILE DRILLING: 36"
	END OF DRILLING: NA
	DATE DRILLED: 10/20/05
	DRILLER: MO-KAN
	GEOLOGIST: D. ROY
	DRILL METHOD: LARGE DIA. BORING