

1 LOCATION OF WATER WELL: Fraction NE ¼ SE ¼ SE ¼ Section Number 24 Township Number T 14 S Range Number R 3 E/W

Distance and direction from nearest town or city street address of well if located within city?

60' W of SW corner of 9th/Kirwin, Salina

2 WATER WELL OWNER: Payne Oil Co.


RR#, St. Address, Box # : P.O. Box 671

Board of Agriculture, Division of Water Resources

City, State, ZIP Code : Salina, Kansas 67402-0671

Application Number:

3 LOCATE WELL'S LOCATION WITH AN "X" IN SECTION BOX:

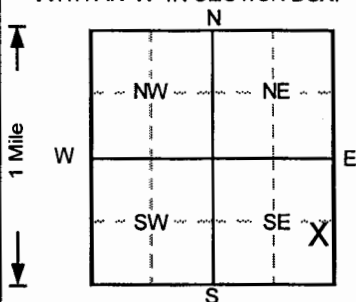

4 DEPTH OF COMPLETED WELL 45 ft. ELEVATION:

Depth(s) Groundwater Encountered 1. ft. 2. ft. 3. ft.

WELL'S STATIC WATER LEVEL ft. below land surface measured on mo/day/yr

Pump test data: Well water was NA ft. after hours pumping gpm

Est. Yield NA gpm: Well water was ft. after hours pumping gpm

Bore Hole Diameter 8 in. to 45 ft. and in. to ft.

WELL WATER TO BE USED AS: 5 Public water supply 8 Air conditioning 11 Injection well

1 Domestic 3 Feedlot 6 Oil field water supply 9 Dewatering 12 Other (Specify below)

2 Irrigation 4 Industrial 7 Lawn and garden only 10 Monitoring well

Was a chemical/bacteriological sample submitted to Department? Yes No If yes, mo/day/yr sample was submitted Water Well Disinfected? Yes No

5 TYPE OF BLANK CASING USED:

1 Steel 3 RMP (SR) 5 Wrought iron 8 Concrete tile CASING JOINTS: Glued Clamped

2 PVC 4 ABS 6 Asbestos-Cement 9 Other (specify below) Welded

Blank casing diameter 2 in. to 25 ft. Dia in. to ft. Dia in. to ft.

Casing height above land surface 0 in., weight lbs./ft. Wall thickness or gauge No. Sch. 40

TYPE OF SCREEN OR PERFORATION MATERIAL

1 Steel 3 Stainless steel 5 Fiberglass 7 PVC 10 Asbestos-cement

2 Brass 4 Galvanized steel 6 Concrete tile 8 RMP (SR) 11 Other (specify)

SCREEN OR PERFORATION OPENINGS ARE: 5 Gauzed wrapped 8 Saw cut 11 None (open hole)

1 Continuous slot 3 Mill slot 6 Wire wrapped 9 Drilled holes

2 Louvered shutter 4 Key punched 7 Torch cut 10 Other (specify)

SCREEN-PERFORATED INTERVALS: From 25 ft. to 45 ft. From ft. to ft.

From ft. to ft. From ft. to ft.

GRAVEL PACK INTERVALS: From 23 ft. to 45 ft. From ft. to ft.

From ft. to ft. From ft. to ft.

6 GROUT MATERIAL: 1 Neat cement 2 Cement grout 3 Bentonite 4 Other Concrete

Grout intervals: From 0 ft. to 1 ft. From 1 ft. to 25 ft. From ft. to ft.

What is the nearest source of possible contamination:

1 Septic tank 4 Lateral lines 7 Pit privy 10 Livestock pens 14 Abandoned water well

2 Sewer lines 5 Cess pool 8 Sewage lagoon 11 Fuel storage 15 Oil well/Gas well

3 Watertight sewer lines 6 Seepage pit 9 Feedyard 12 Fertilizer storage 16 Other (specify below)

Direction from well?

How many feet?

FROM	TO	LITHOLOGIC LOG	FROM	TO	PLUGGING INTERVALS
0	0.5	Concrete,			
0.5	2	Clay, moist, plastic, no odor,			
2	6	Clay, v. silty, moist, plastic, no odor,			
6	13	Clay, decr. silty, moist, plastic, no odor, Brow			
13	16	Silt, moist, no odor, Brown			
16	18	Sand (vf-f), silty, moist, no odor, Brown to Re			
18	21	Clay, silty, moist-v. moist, no odor, Brown			
21	22	Silt, saturated, no odor, brown			
22	24	Clay, silty, moist, no odor,			
24	31.5	Clay, v. stiff, tight, no odor, Brown mottled ru			
31.5	35	Clay, silty, moist, no odor, Lt. Gray mottled ru			
35	40	Sand (vf-c) w/f gravel, saturated, Grayish Bro			
40	45	Sand (vf-c) w/f gravel, saturated, no odor, Bro			
					SSMW3R, Tag # 00376363, Flushmount
					Project Name: Southside Service/Sinclair - Monitoring
					GeoCore # 329, KDHE # U5 085 00862

7 CONTRACTOR'S OR LANDOWNER'S CERTIFICATION: This water well was (1) constructed, (2) reconstructed, or (3) plugged under my jurisdiction and was completed on (mo/day/year) 9/5/2006 and this record is true to the best of my knowledge and belief.

Kansas Water Well Contractor's License No. 527 This Water Well Record was completed on (mo/day/yr) 9/12/06

under the business name of GeoCore, Inc. by (signature) Dab Bell