


1	LOCATION OF WATER WELL:	Fraction	Section Number			Township Number			Range Number		
County: Saline		NW ¼ NE ¼ NW ¼	26			T 14 S			R 3 E 14		

Distance and direction from nearest town or city street address of well if located within city?
1121 W. Cloud, Salina

2 WATER WELL OWNER: Kwik Shop, Inc.		
RR#, St. Address, Box #	P.O. Box 1927	Board of Agriculture, Division of Water Resources Application Number:
City, State, ZIP Code	Hutchinson, Kansas 67504-1927	

3] LOCATE WELL'S LOCATION
WITH AN "X" IN SECTION BOX:

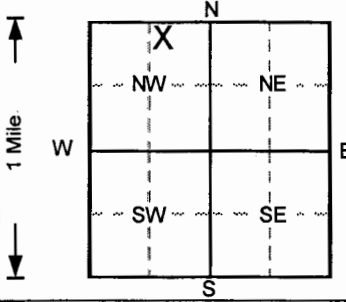

4 DEPTH OF COMPLETED WELL 42 ft. ELEVATION:
 Depth(s) Groundwater Encountered 1. ft. 2. ft. 3. ft.
 WELL'S STATIC WATER LEVEL ft. below land surface measured on mo/day/yr
 Pump test data: Well water was NA ft. after hours pumping gpm
 Est. Yield NA gpm: Well water was ft. after hours pumping gpm
 Bore Hole Diameter 8 in. to 42 ft., and in. to ft.
 WELL WATER TO BE USED AS: 5 Public water supply 8 Air conditioning 11 Injection well
 1 Domestic 3 Feedlot 6 Oil field water supply 9 Dewatering 12 Other (Specify below)
 2 Irrigation 4 Industrial 7 Lawn and garden only 10 Monitoring well
 Was a chemical/bacteriological sample submitted to Department? Yes.....No✓; If yes, mo/day/yr sample was
 submitted Water Well Disinfected? Yes No✓

5 TYPE OF BLANK CASING USED:

1 Steel 3 RMP (SR) 6 Asbestos-Cement 9 Other (specify below) Welded
 2 PVC 4 ABS 7 Fiberglass Threaded. ☒
 Blank casing diameter 2 in. to 27 ft. Dia in. to ft. Dia in. to ft.
 Casing height above land surface 0 in., weight lbs./ft. Wall thickness or gauge No. Sch. 40

TYPE OF SCREEN OR PERFORATION MATERIAL

1 Steel 3 Stainless steel 5 Fiberglass 8 RMP (SR) 11 Other (specify)

2 Brass 4 Galvanized steel 6 Concrete tile 9 ABS 12 None used (open hole)

SCREEN OR PERFORATION OPENINGS ARE:

1 Continuous slot 3 Mill slot 5 Gauzed wrapped 8 Saw cut 11 None (open hole)

2 Louvered shutter 4 Key punched 6 Wire wrapped 9 Drilled holes

7 Torch cut 10 Other (specify)

SCREEN-PERFORATED INTERVALS:	From	27	ft to	42	ft,	From		ft. to		f
	From		ft to		ft,	From		ft. to		f
GRAVEL PACK INTERVALS:	From	25	ft to	42	ft,	From		ft. to		f
	From		ft to		ft,	From		ft. to		f

6 GROUT MATERIAL:

Grout intervals: From 0 ft. to 1 ft., From 1 ft. to 25 ft., From ft. to ft.

What is the nearest source of possible contamination:

1 Septic tank	4 Lateral lines	7 Pit privy	10 Livestock pens	14 Abandoned water well
2 Sewer lines	5 Cess pool	8 Sewage lagoon	11 Fuel storage	15 Oil well/Gas well
3 Watertight sewer lines	6 Seepage pit	9 Feedyard	12 Fertilizer storage	16 Other (specify below)
Direction from well?			13 Insecticide storage	
			How many feet?	

FROM	TO
------	----

0	1	Asphalt with gravel subbase,			
1	5	Clay, silty, abnt root casts and rust, soft, Olive			
5	10	Clay, some silt, w/abundant rust spots, Olive B			
10	15	Clay, some silt, abundant rust stringers, Olive			
15	20	Clay, some silt, stiff, low plasticity,, Med. Bro			
20	25	Clay w/silt, v. soft, low plasticity, damp, Med.			
25	30	Clay, some silt, v. soft, low plasticity, damp, Ol			
30	35	Silt, tr. clay, v. soft, tr. plasticity, Med. Brown			
35	42	Sand. (c) w/f-m sand, stained black @ 35'. Mul			

MW3 , Flushmount
Project Name: Trileaf - Kwik Shop, West Cloud, Salina
GeoCore # 1319 , #

7 CONTRACTOR'S OR LANDOWNER'S CERTIFICATION: This water well was (1) constructed, (2) reconstructed, or (3) plugged under my jurisdiction and was completed on (mo/day/year) 8/15/2006 and this record is true to the best of my knowledge and belief.
Kansas Water Well Contractor's License No. 527 This Water Well Record was completed on (mo/day/yr) 9/15/06
under the business name of GeoCore, Inc. by (signature) Dae Ngy