

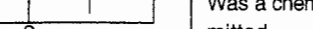
1 LOCATION OF WATER WELL:		Fraction		Section Number		Township Number		Range Number	
County:	Saline	NE ¼	SE ¼	NE ¼	36	T	14 S	R	3 EW

	SW	SE	NE	NW	S	E	N	W
Distance and direction from nearest town or city street address of well if located within city?								

940 Twin Oaks, Salina

2 WATER WELL OWNER : Jon Freeman
RR#, St. Address, Box # : 940 Twin Oaks
City, State, ZIP Code : Salina, KS 67401

Board of Agriculture, Division of Water Resources
Application Number:

3 LOCATE WELL'S LOCATION WITH AN "X" IN SECTION BOX: 	4 DEPTH OF COMPLETED WELL . . . 49 . . . ft. ELEVATION: Depth(s) Groundwater Encountered 1. ft. 2. ft. 3. ft. WELL'S STATIC WATER LEVEL ft. below land surface measured on mo/day/yr Pump test data: Well water was ft. after hours pumping gpm Est. Yield .. 50+ .. gpm: Well water was ft. after hours pumping gpm Bore Hole Diameter. . . 10.5 . . in. to . . . 50 . . ft., and. in. to ft. WELL WATER TO BE USED AS: 1 Domestic 3 Feedlot 6 Oil field water supply 9 Dewatering 12 Other (Specify below) 2 Irrigation 4 Industrial 7 Domestic (lawn & garden) 10 Monitoring well Was a chemical/bacteriological sample submitted to Department? Yes. No. X ; If yes, mo/day/yrs sample was sub- Water Well Disinfected? Yes X No
---	---

5 TYPE OF BLANK CASING USED:

1 Steel	3 RMP (SR)	5 Wrought iron	8 Concrete tile	CASING JOINTS: Glued. <input checked="" type="checkbox"/> Clamped.
2 PVC	4 ABS	6 Asbestos-Cement	9 Other (specify below)	Welded
		7 Fiberglass		Threaded.

Blank casing diameter ... 4.5 ... in. to 42 ... ft., Dia ... in. to ... ft., Dia ... in. to ... ft.

Casing height above land surface ... 1.8 ... in., weight ... 1.60 ... lbs./ft. Wall thickness or gauge No.

TYPE OF SCREEN OR PERFORATION MATERIAL:

1 Steel	3 Stainless steel	5 Fiberglass	7 PVC	10 Asbestos-cement
2 Brass	4 Galvanized steel	6 Concrete tile	8 RMP (SR)	11 Other (specify)
			9 ABS	12 None used (open hole)

SCREEN OR PERFORATION OPENINGS ARE:

1 Continuous slot	3 Mill slot	5 Gauzed wrapped	8 Saw cut	11 None (open hole)
2 Louvered shutter	4 Key punched	6 Wire wrapped	9 Drilled holes	
		7 Torch cut	10 Other (specify)	ft.

SCREEN-PERFORATED INTERVALS: From ... 42 ... ft. to 49 ... ft., From ... ft. to ... ft.

GRAVEL PACK INTERVALS: From ... 21.5 ... ft. to 49 ... ft., From ... ft. to ... ft.

6] GROUT MATERIAL:		1 Neat cement	2 Cement grout	3 Bentonite	4 Other
Grout Intervals: From 0 ft. to 21.5 ft., From ft. to ft., From ft. to ft.					
What is the nearest source of possible contamination:			10 Livestock pens	14 Abandoned water well	
1 Septic tank	4 Lateral lines	7 Pit privy	11 Fuel storage	15 Oil well/Gas well	
2 Sewer lines	5 Cess pool	8 Sewage lagoon	12 Fertilizer storage	16 Other (specify below)	
3 Watertight sewer lines	6 Seepage pit	9 Feedyard	13 Insecticide storage		
Direction from well? NE		How many feet? 40			

[illegible]

7] CONTRACTOR'S OR LANDOWNER'S CERTIFICATION: This water well was (1) constructed, (2) reconstructed, or (3) plugged under my jurisdiction and was completed on (mo/day/year) 10/6/2006 and this record is true to the best of my knowledge and belief. Kansas Water Well Contractor's Licence No. 527 This Water Well Record was completed on (mo/day/yr) 10/25/2006 under the business name of GeoCore Inc. by (signature) 