


|                           |                                                                         |                |                             |                             |
|---------------------------|-------------------------------------------------------------------------|----------------|-----------------------------|-----------------------------|
| 1 LOCATION OF WATER WELL: | Fraction                                                                | Section Number | Township Number             | Range Number                |
| County: <u>Saline</u>     | <u>SE</u> $\frac{1}{4}$ <u>NW</u> $\frac{1}{4}$ <u>NW</u> $\frac{1}{4}$ | <u>36</u>      | <u>T</u> <u>14</u> <u>S</u> | <u>R</u> <u>3</u> <u>EW</u> |

Distance and direction from nearest town or city street address of well if located within city?  
2501 Simmons, Salina

|                           |                  |                                                   |
|---------------------------|------------------|---------------------------------------------------|
| 2] WATER WELL OWNER :     | Corey Ferguson   |                                                   |
| RR#, St. Address, Box # : | 2501 Simmons     | Board of Agriculture, Division of Water Resources |
| City, State, ZIP Code :   | Salina, KS 67401 | Application Number:                               |

|   |                             |   |                                                        |
|---|-----------------------------|---|--------------------------------------------------------|
| 3 | LOCATE WELL'S LOCATION WITH | 4 | DEPTH OF COMPLETED WELL.....55.....ft. ELEVATION:..... |
|---|-----------------------------|---|--------------------------------------------------------|

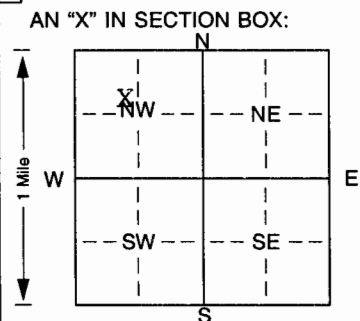

4 DEPTH OF COMPLETED WELL ..... 55 ..... ft. ELEVATION: .....  
 Depth(s) Groundwater Encountered 1. .... 23 ..... ft. 2. .... ft. 3. .... ft.  
 WELL'S STATIC WATER LEVEL ..... ft. below land surface measured on mo/day/yr .....  
 Pump test data: Well water was ..... ft. after ..... hours pumping ..... gpm  
 Est. Yield .... 30 ..... gpm: Well water was ..... ft. after ..... hours pumping ..... gpm  
 Bore Hole Diameter ..... in. to ..... ft., and ..... in. to ..... ft.  
 WELL WATER TO BE USED AS: 5 Public water supply 8 Air conditioning 11 Injection well  
 1 Domestic 3 Feedlot 6 Oil field water supply 9 Dewatering 12 Other (Specify below)  
 2 Irrigation 4 Industrial ⑦ Domestic (lawn & garden) 10 Monitoring well .....  
 Was a chemical/bacteriological sample submitted to Department? Yes. .... No. ☒ ; If yes, mo/day/yr sample was submitted  
 Water Well Disinfected? Yes No ☒

|   |                            |                |                 |                                                    |
|---|----------------------------|----------------|-----------------|----------------------------------------------------|
| 5 | TYPE OF BLANK CASING USED: | 5 Wrought iron | 8 Concrete tile | CASING JOINTS: Glued. . . X . . . Clamped. . . . . |
|---|----------------------------|----------------|-----------------|----------------------------------------------------|

|         |            |                   |                         |                |
|---------|------------|-------------------|-------------------------|----------------|
| 1 Steel | 3 RMP (SR) | 6 Asbestos-Cement | 9 Other (specify below) | Welded .....   |
| 2 PVC   | 4 ABS      | 7 Fiberglass      |                         | Threaded ..... |

Blank casing diameter . . . . . 4.5 in. to 50 ft, Dia . . . . . in. to . . . . . ft, Dia . . . . . in. to . . . . . ft  
Casing height above land surface. 12 in., weight . . . . . 160 lbs./ft. Wall thickness or gauge No. . . . .

|                                         |                    |                 |            |                          |
|-----------------------------------------|--------------------|-----------------|------------|--------------------------|
| TYPE OF SCREEN OR PERFORATION MATERIAL: |                    |                 | 7 PVC      | 10 Asbestos-cement       |
| 1 Steel                                 | 3 Stainless steel  | 5 Fiberglass    | 8 RMP (SR) | 11 Other (specify) ..... |
| 2 Brass                                 | 4 Galvanized steel | 6 Concrete tile | 9 ABS      | 12 None used (open hole) |

|                                     |               |                  |                          |                     |
|-------------------------------------|---------------|------------------|--------------------------|---------------------|
| SCREEN OR PERFORATION OPENINGS ARE: |               | 5 Gauzed wrapped | 8 Saw cut                | 11 None (open hole) |
| 1 Continuous slot                   | 3 Mill slot   | 6 Wire wrapped   | 9 Drilled holes          |                     |
| 2 Louvered shutter                  | 4 Key punched | 7 Torch cut      | 10 Other (specify) ..... | ft.                 |

|                              |  |          |           |           |        |     |
|------------------------------|--|----------|-----------|-----------|--------|-----|
| SCREEN-PERFORATED INTERVALS: |  | From. 50 | ft. to 55 | ft., From | ft. to | ft. |
|                              |  | From.    | ft. to    | ft., From | ft. to | ft. |
| GRAVEL PACK INTERVALS:       |  | From. 20 | ft. to 55 | ft., From | ft. to | ft. |
|                              |  | From.    | ft. to    | ft., From | ft. to | ft. |

6 GROUT MATERIAL: 1 Neat cement 2 Cement grout 3 Bentonite 4 Other .....

Grout Intervals: From 0 ft. to 20 ft., From . ft. to . ft., From . ft. to . ft.

What is the nearest source of possible contamination:

|                          |                 |                 |                        |                          |
|--------------------------|-----------------|-----------------|------------------------|--------------------------|
| 1 Septic tank            | 4 Lateral lines | 7 Pit privy     | 10 Livestock pens      | 14 Abandoned water well  |
| 2 Sewer lines            | 5 Cess pool     | 8 Sewage lagoon | 11 Fuel storage        | 15 Oil well/Gas well     |
| 3 Watertight sewer lines | 6 Seepage pit   | 9 Feedyard      | 12 Fertilizer storage  | 16 Other (specify below) |
|                          |                 |                 | 13 Insecticide storage | .....                    |

|                      |         |                |
|----------------------|---------|----------------|
| Direction from well? | Unknown | How many feet? |
|----------------------|---------|----------------|

[illegible]

7 CONTRACTOR'S OR LANDOWNER'S CERTIFICATION: This water well was (1) constructed, (2) reconstructed, or (3) plugged under my jurisdiction and was completed on (mo/day/year) 6/1/2007 and this record is true to the best of my knowledge and belief. Kansas Water Well Contractor's Licence No. 527 This Water Well Record was completed on (mo/day/yr) 6/11/2007 under the business name of GeoCore Inc. by (signature) [Signature]