


353 N. 7th St., Salina

Application Number:

4	DEPTH OF COMPLETED WELL	40	ft. ELEVATION:
---	-------------------------	----	----------------

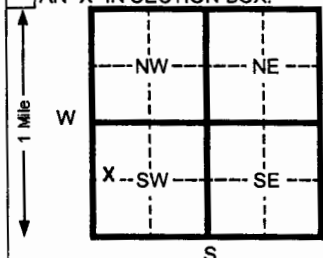

Water Well Disinfected? Yes No **X**

INSTRUCTIONS: Please fill in blanks and circle the correct answers. Send three copies to Kansas Department of Health and Environment, Bureau of Water, 1600 S. Jackson St., Ste. 420, Topeka, Kansas 66612-1367. Telephone: 913-296-5545. Send one to WATER WELL OWNER and retain one for your records.