

1	LOCATION OF WATER WELL:	Fraction	Section Number	Township Number	Range Number
	County: SALINE	NE 1/4 NW 1/4 SW 1/4	13	14S	3W
Distance and direction from nearest town or city street address of well if located within city?					
501 S. SANTA FE, SALINA, KS 67401					

2	WATER WELL OWNER: SALINA REGIONAL MEDICAL CENTER				
	RR #, St. Address, Box # 440 SANTA FE		Board of Agriculture, Division of Water Resources		
	City, State, ZIP Code SALINA, KS 67401		Application Number:		

3	MARK WELL'S LOCATION WITH AN "X" IN SECTION BOX:	4	DEPTH OF WELL 37.60 ft.										
		WELL'S STATIC WATER LEVEL Dry ft.											
		WELL WAS USED AS:											
		<table style="width:100%;"> <tr> <td>1 Domestic</td> <td>5 Public Water Supply</td> <td>9 Dewatering</td> </tr> <tr> <td>2 Irrigation</td> <td>6 Oil Field Water Supply</td> <td><u>10 Monitoring Well</u></td> </tr> <tr> <td>3 Feedlot</td> <td>7 Domestic (Lawn & Garden)</td> <td>11 Injection Well</td> </tr> <tr> <td>4 Industrial</td> <td>8 Air Conditioning</td> <td>12 Other</td> </tr>
Was a chemical / bacteriological sample submitted to Department? Yes No X													
if yes, mo/day/yr sample was submitted													
Water Well Disinfected: Yes No X													

5	TYPE OF BLANK CASING USED:		
	1 Steel	3 RMP (SR)	5 Wrought
	<u>2 PVC</u>	4 ABS	6 Asbestos-Cement
			7 Fiberglass
			9 Other (Specify below)
	Blank casing diameter 1" in.		
	Casing height above or below land surface 36" in.		
	Was casing pulled? Yes X No		
	If yes, how much 36"		

6	GROUT PLUG MATERIAL: 1 Neat cement 2 Cement grout <u>3 Bentonite</u> 4 Other																						
	Grout Plug Intervals: From 37.60 ft. to 0' ft., From ft. to ft., From ft. to ft.																						
What is the nearest source of possible contamination:																							
<table style="width:100%;"> <tr> <td>1 Septic tank</td> <td>6 Seepage pit</td> <td><u>11 Fuel storage</u></td> <td>16 Other (specify below)</td> </tr> <tr> <td>2 Sewer lines</td> <td>7 Pit privy</td> <td>12 Fertilizer storage</td> <td></td> </tr> <tr> <td>3 Watertight sewer lines</td> <td>8 Sewage lagoon</td> <td>13 Insecticide storage</td> <td></td> </tr> <tr> <td>4 Lateral lines</td> <td>9 Feedyard</td> <td>14 Abandoned water well</td> <td></td> </tr> <tr> <td>5 Cess pool</td> <td>10 Livestock pens</td> <td>15 Oil well/Gas well</td> <td></td> </tr> </table>				1 Septic tank	6 Seepage pit	<u>11 Fuel storage</u>	16 Other (specify below)	2 Sewer lines	7 Pit privy	12 Fertilizer storage		3 Watertight sewer lines	8 Sewage lagoon	13 Insecticide storage		4 Lateral lines	9 Feedyard	14 Abandoned water well		5 Cess pool	10 Livestock pens	15 Oil well/Gas well	
1 Septic tank	6 Seepage pit	<u>11 Fuel storage</u>	16 Other (specify below)																				
2 Sewer lines	7 Pit privy	12 Fertilizer storage																					
3 Watertight sewer lines	8 Sewage lagoon	13 Insecticide storage																					
4 Lateral lines	9 Feedyard	14 Abandoned water well																					
5 Cess pool	10 Livestock pens	15 Oil well/Gas well																					
Direction from well? <u>IMMEDIATE VICINITY</u> How many feet? <u>IMMEDIATE VICINITY</u>																							

FROM	TO	PLUGGING MATERIALS
37.60	0	Bentonite Hydrated
		MW-15


7	CONTRACTOR'S OF LANDOWNER'S CERTIFICATION: This water well was plugged under my jurisdiction and was completed on (mo/day/year) 10/15/07 and this record is true to the best of my knowledge and belief. Kansas Water Well Contractor's License No. 665 This Water Well Record was completed on (mo/day/year) 10/15/07 under the business name of Pratt Well Environmental		
	by (signature)		

INSTRUCTIONS: Use typewriter or ball point pen. Please press firmly and print clearly. Please fill in blanks, underline or circle the correct answers. Send top three copies to Kansas Department of Health and Environment, Bureau of Water, Geology Section, 1 000 SW Jackson St., Ste. 420, Topeka, Kansas 66612-1367. Telephone: 785/296-5522. Send one to Water Well Owner and retain one for your records.

● WELL
R RESIDENCE
🚗 ABANDONED

OB-1	N:38deg	49.861'	W:97deg	36.566'
OB-3	N:38deg	49.847'	W:97deg	36.598'
OB-4	N:38deg	49.850'	W:97deg	36.579'
OB-5	N:38deg	49.891'	W:97deg	36.538'
DC-2	N:38deg	49.856'	W:97deg	36.472'
DC-2S	N:38deg	49.859'	W:97deg	36.473'
EC-OB-5	N:38deg	49.877'	W:97deg	36.534'
PW-7	N:38deg	49.920'	W:97deg	36.541'
MW-10N	N:38deg	49.993'	W:97deg	36.471'
MW-10S	N:38deg	49.990'	W:97deg	36.472'
MW-10R	N:38deg	49.993'	W:97deg	36.477'
MW-11	N:38deg	49.947'	W:97deg	36.477'
MW-12	N:38deg	50.016'	W:97deg	36.471'
MW-13	N:38deg	50.040'	W:97deg	36.472'
MW-14	N:38deg	50.037'	W:97deg	36.421'
MW-15	N:38deg	49.974'	W:97deg	36.414'
MW-19	N:38deg	49.964'	W:97deg	36.541'
MW-20	N:38deg	49.898'	W:97deg	36.512'
MW-21	N:38deg	49.896'	W:97deg	36.491'
MW-22	N:38deg	49.888'	W:97deg	36.411'

SVE-2 N:38deg 49.854' W:97deg 36.542'
SVE-4 N:38deg 49.856' W:97deg 36.574'
SVE-5 N:38deg 49.854' W:97deg 36.564'

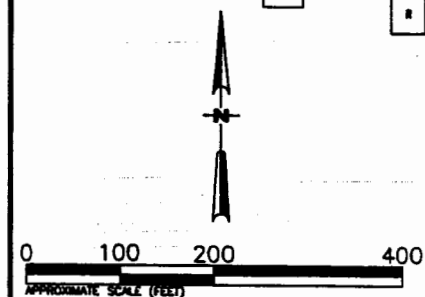

PROJ. # 17102554	PAGE #
SCALE: AS SHOWN	DRAWN BY: CLE
FILE NO. 2554-F1	DESIGNED BY:
DATE: 8-24-07	APPROVED BY:

FIGURE 1
SITE PLAN

SALINA REGIONAL MEDICAL CENTER
540 SOUTH SANTA FE
SALINA, KANSAS