

CORRECTION(S) TO WATER WELL RECORD (WWC-5)

(to rectify lacking or incorrect information)

County: Saline

Location listed as:

Section-Township-Range: None Given

Fraction ($\frac{1}{4}$ $\frac{1}{4}$ $\frac{1}{4}$): _____

Location changed to:

26-14S-3W

NW NE NE NW

Other changes: Initial statements: _____

Changed to: _____

Comments: _____

verification method: well address, city street map, and
mapping tool on KGS website.

initials: ORA date: 3/17/2008

submitted by: Kansas Geological Survey, Data Resources Library, 1930 Constant Ave., Lawrence, KS 66047-3726
to: Kansas Dept of Health & Environment, Bureau of Water, 1000 SW Jackson, Suite 420, Topeka, KS 66612-1367.

1 LOCATION OF WATER WELL: County: <u>SALINE</u>		Fraction <u>1/4</u> <u>1/4</u> <u>1/4</u>	Section Number	Township Number T S	Range Number R E/W								
Distance and direction from nearest town or city street address of well if located within city? <u>1121 W. Cloud SALINA, KS.</u>			Global Positioning Systems (decimal degrees, min. of 4 digits) Latitude: _____ Longitude: _____ Elevation: _____ Datum: _____ Data Collection Method: _____										
2 WATER WELL OWNER: <u>Kwik</u> RR#, St. Address, Box # : _____ City, State, ZIP Code : _____													
3 LOCATE WELL'S LOCATION WITH AN "X" IN SECTION BOX: N <table border="1"><tr><td>-- NW --</td><td>-- NE --</td></tr><tr><td>W</td><td>E</td></tr><tr><td>-- SW --</td><td>-- SE --</td></tr><tr><td>S</td><td></td></tr></table>		-- NW --	-- NE --	W	E	-- SW --	-- SE --	S		4 DEPTH OF COMPLETED WELL <u>35</u> ft. Depth(s) Groundwater Encountered (1)..... <u>31</u> ft. (2)..... ft. (3)..... ft. WELL'S STATIC WATER LEVEL..... ft. below land surface measured on mo/day/yr..... Pump test data: Well water was..... ft. after..... hours pumping..... gpm Est. Yield.....gpm: Well water was..... ft. after..... hours pumping..... gpm WELL WATER TO BE USED AS: 5 Public water supply 8 Air conditioning 11 Injection well 1 Domestic 3 Feedlot 6 Oil field water supply 9 Dewatering 12 Other (Specify below) 2 Irrigation 4 Industrial 7 Domestic (lawn & garden) <u>10 Monitoring well</u> Was a chemical/bacteriological sample submitted to Department? Yes No; If yes, mo/day/yr Sample was submitted..... Water well disinfected? Yes No			
-- NW --	-- NE --												
W	E												
-- SW --	-- SE --												
S													
5 TYPE OF CASING USED: 1 Steel 3 RMP (SR) 6 Asbestos-Cement 9 Other (specify below) <u>2 PVC</u> 4 ABS 7 Fiberglass <u>Threaded</u> Blank casing diameter <u>2</u> in. to <u>35</u> ft., Diameter. in. to ft., Diameter in. to ft. Casing height above land surface..... in., Weight lbs./ft. Wall thickness or guage No. TYPE OF SCREEN OR PERFORATION MATERIAL: 1 Steel 3 Stainless Steel 5 Fiberglass <u>7 PVC</u> 9 ABS 11 Other (Specify) 2 Brass 4 Galvanized Steel 6 Concrete tile 8 RM (SR) 10 Asbestos-Cement 12 None used (open hole) SCREEN OR PERFORATION OPENINGS ARE: 1 Continuous slot <u>3 Mill slot</u> 5 Gauzed wrapped 7 Torch cut 9 Drilled holes 11 None (open hole) 2 Louvered shutter 4 Key punched 6 Wire wrapped 8 Saw Cut 10 Other (specify) SCREEN-PERFORATED INTERVALS: From..... <u>25</u> ft. to <u>35</u> ft., From ft. to ft. From..... ft. to ft., From ft. to ft. GRAVEL PACK INTERVALS: From..... ft. to ft., From ft. to ft. From..... ft. to ft., From ft. to ft.													
6 GROUT MATERIAL: 1 Neat cement 2 Cement grout <u>4 Bentonite</u> 4 Other Grout Intervals: From <u>1</u> ft. to <u>13</u> ft., From ft. to ft., From ft. to ft. What is the nearest source of possible contamination: 1 Septic tank 4 Lateral lines 7 Pit privy 10 Livestock pens 13 Insecticide Storage 16 Other (specify below) 2 Sewer lines 5 Cess pool 8 Sewage lagoon 11 Fuel storage 14 Abandoned water well 3 Watertight sewer lines 6 Seepage pit 9 Feedyard 12 Fertilizer Storage 15 Oil well/gas well Direction from well? How many feet?													
FROM	TO	LITHOLOGIC LOG		FROM	TO	PLUGGING INTERVALS							
		SEE ATTACHMENT											
7 CONTRACTOR'S OR LANDOWNER'S CERTIFICATION: This water well was (1) <u>constructed</u> , (2) reconstructed, or (3) plugged under my jurisdiction and was completed on (mo/day/year) <u>1-17-08</u> and this record is true to the best of my knowledge and belief. Kansas Water Well Contractor's License No. <u>728</u> This Water Well Record was completed on (mo/day/year) <u>2-13-08</u> under the business name of <u>JCC LTD DBA JC DRILLING</u> by (signature) <u>[Signature]</u>													
INSTRUCTIONS: Use typewriter or ball point pen. PLEASE PRESS FIRMLY and PRINT clearly. Please fill in blanks, underline or circle the correct answers. Send top three copies to Kansas Department of Health and Environment, Bureau of Water, Geology Section, 1000 SW Jackson St., Suite 420, Topeka, Kansas 66612-1367. Telephone 785-296-5522. Send one to WATER WELL OWNER and retain one for your records. Fee of \$5.00 for each <u>constructed</u> well. Visit us at http://www.kdheks.gov/waterwell/index.html .													

SOIL BORING AND MONITORING WELL CONSTRUCTION DIAGRAM

Boring/Well Number: MW-11

Facility Name:

Kwik Shop 708

Facility Street Address:

1121 West Cloud, Salina, KS

Boring Depth (ft) X Diameter (in): 35' x 8 3/4"

*Drilling Method:

HS w/ CS

Well Contractor Name: JC Drilling

Registration#: 531

Logged by: Matt Hortsho

Ground Surface Elevation (ASL): 1,235.42

Top of Casing Elevation (ASL): 1.234.96

Date: 1-17-2008

Date: 1-17-2008

KDHE Facility ID:

KDHE Project Code:

Start Time: 3:00pm

End Time: 4:00pm

07702

U5-085-13576

Depth
(feet)

Well Construction Details


Graphic Log

Sample

Type

PID
Reading

Rock Formations, Soil, Color and
Classifications, Observations
(moisture, odor, etc.)

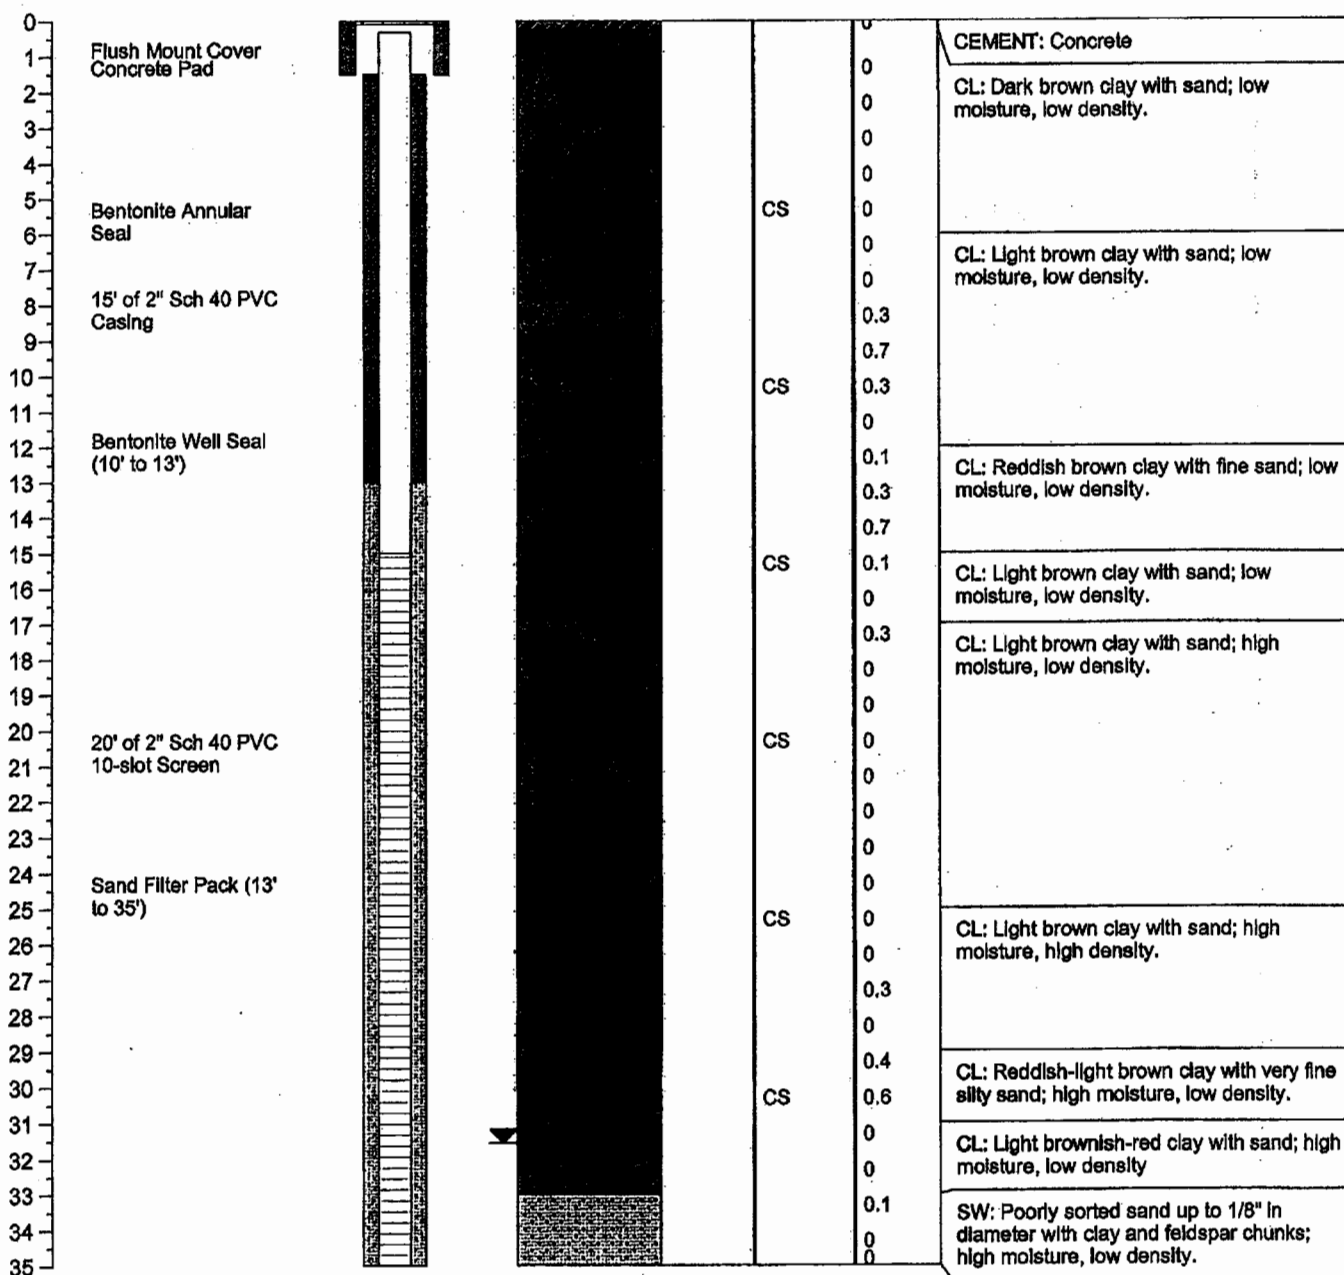

SS (split spoon)

HS (hollow stem auger)

HA (hand auger)

CS (continuous sampler)

G (geoprobe)