WATER WELL PLUGGING RECORD Form WWC-5P KSA 82a-1212 ID NO. 00117601

1 LOCATION OF WATER WELL:	Fraction	Section Number	Township Number	Range Number
County: Saline	NE ¼ NE ¼ NE ¼	2	14 S	3 E(W)

Distance and direction from nearest town or city street address of well if located within city?
1745 N. 9th St., Salina

2 WATER WELL OWNER: SEI Partners, LP
RR #, St. Address, Box #: 2900 West 121st Street
City, State, ZIP Code : Leawood, KS 66209-1181
Board of Agriculture, Division of Water Resources
Application Number:

3 MARK WELL'S LOCATION WITH AN "X" IN SECTION BOX:

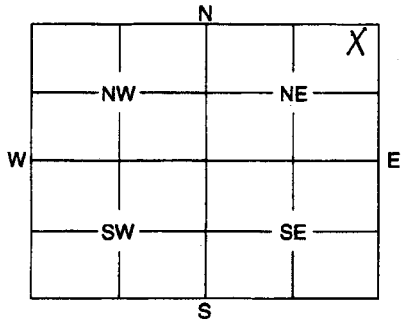

4 DEPTH OF WELL 20.5 ft.
WELL'S STATIC WATER LEVEL N/A ft.
WELL WAS USED AS:

1 Domestic 5 Public Water Supply 9 Dewatering
2 Irrigation 6 Oil Field Water Supply 10 Monitoring Well
3 Feedlot 7 Domestic (Lawn & Garden) 11 Injection Well
4 Industrial 8 Air Conditioning ● Other Soil vapor extraction

Was a chemical / bacteriological sample submitted to Department? Yes ..... No ✓
If yes, mo/day/yr sample was submitted .....
Water Well Disinfected: Yes ..... No ✓

5 TYPE OF BLANK CASING USED:

1 Steel 3 RMP (SR) 5 Wrought 7 Fiberglass 9 Other (Specify below)
● PVC 4 ABS 6 Asbestos-Cement 8 Concrete Tile .....

Blank casing diameter 2 in. Was casing pulled? Yes ✓ No ..... If yes, how much 2'
Casing height above or below land surface N/A in.

6 GROUT PLUG MATERIAL: 1 Neat cement 2 Cement grout ● Bentonite ● Other Concrete
Grout Plug Intervals: From 0 ft. to 0.5 ft., From 0.5 ft. to 20.5 ft., From ..... to ..... ft.

What is the nearest source of possible contamination:

1 Septic tank 6 Seepage pit 11 Fuel storage 16 Other (specify below)
2 Sewer lines 7 Pit privy 12 Fertilizer storage .....
3 Watertight sewer lines 8 Sewage lagoon 13 Insecticide storage
4 Lateral lines 9 Feedyard 14 Abandoned water well
5 Cess pool 10 Livestock pens 15 Oil well/Gas well

Direction from well? ..... How many feet? .....

FROM	TO	PLUGGING MATERIALS
0	0.5	Concrete
0.5	20.5	Bentonite (2")

SVE3

KDHE #U5 085 00244

GeoCore 1005

7 CONTRACTOR'S OF LANDOWNER'S CERTIFICATION: This water well was plugged under my jurisdiction and was completed on (mo/day/year) 5/8/2008 and this record is true to the best of my knowledge and belief. Kansas Water Well Contractor's License No. 527 This Water Well Record was completed on (mo/day/year) 5/12/2008 under the business name of Geocore Inc.
by (signature) .....

INSTRUCTIONS: Use typewriter or ball point pen. Please press firmly and print clearly. Please fill in blanks, underline or circle the correct answers. Send top three copies to Kansas Department of Health and Environment, Bureau of Water, Geology Section, 1000 SW Jackson St., Ste. 420, Topeka, Kansas 66612-1367. Telephone: 785/296-5522. Send one to Water Well Owner and retain one for your records.