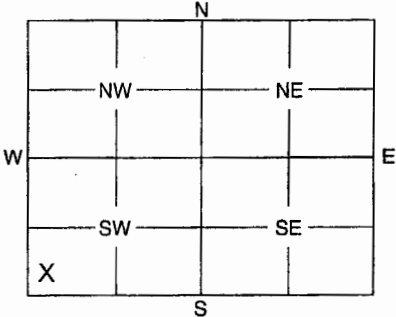


1	LOCATION OF WATER WELL:	Fraction	Section Number	Township Number	Range Number
County:	Saline	SW $\frac{1}{4}$ SW $\frac{1}{4}$ SW $\frac{1}{4}$	12	14S	3

Distance and direction from nearest town or city street address of well if located within city?
301 West Ash Street, Salina, Kansas


2	WATER WELL OWNER: Bill Reimold	
RR #, St. Address, Box #: P.O. Box 1302		Board of Agriculture, Division of Water Resources
City, State, ZIP Code : Salina, KS 67402		Application Number:

3	MARK WELL'S LOCATION WITH AN "X" IN SECTION BOX:	4	DEPTH OF WELL 38 ft.
		WELL'S STATIC WATER LEVEL 29.94 ft.	
		WELL WAS USED AS:	
		1 Domestic 5 Public Water Supply 9 Dewatering	
		2 Irrigation 6 Oil Field Water Supply 10 Monitoring Well	
		3 Feedlot 7 Domestic (Lawn & Garden) 11 Injection Well	
		4 Industrial 8 Air Conditioning 12 Other	
		Was a chemical / bacteriological sample submitted to Department? Yes No <input checked="" type="checkbox"/> X	
		If yes, mo/day/yr sample was submitted	
		Water Well Disinfected: Yes No <input checked="" type="checkbox"/> X	

5	TYPE OF BLANK CASING USED:			
1 Steel 3 RMP (SR) 5 Wrought 7 Fiberglass 9 Other (Specify below)				
<input checked="" type="radio"/> 2 PVC 4 ABS 6 Asbestos-Cement 8 Concrete Tile				
Blank casing diameter 2 in. Was casing pulled? Yes <input checked="" type="checkbox"/> X No If yes, how much ~ 3 feet cut off below grade				
Casing height above or below land surface in.				

6	GROUT PLUG MATERIAL: 1 Neat cement 2 Cement grout <input checked="" type="radio"/> 3 Bentonite <input checked="" type="radio"/> 4 Other Topsoil/grass			
Grout Plug Intervals: From 38 ft. to 3 ft., From 3 ft. to 0 ft., From to ft.				
What is the nearest source of possible contamination:				
1 Septic tank 6 Seepage pit 11 Fuel storage <input checked="" type="radio"/> 16 Other (specify below) Former USTs				
2 Sewer lines 7 Pit privy 12 Fertilizer storage				
3 Watertight sewer lines 8 Sewage lagoon 13 Insecticide storage				
4 Lateral lines 9 Feedyard 14 Abandoned water well				
5 Cess pool 10 Livestock pens 15 Oil well/Gas well				
Direction from well? How many feet?				

FROM	TO	PLUGGING MATERIALS
38	3	Bentonite
3	0	Topsoil/grass

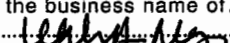7	CONTRACTOR'S OF LANDOWNER'S CERTIFICATION: This water well was plugged under my jurisdiction and was completed on (mo/day/year) 10/1/2008 and this record is true to the best of my knowledge and belief. Kansas Water Well Contractor's License No. 708 This Water Well Record was completed on (mo/day/year) 10/2/2008 under the business name of Aquaterra Environmental Solutions, Inc. by (signature) 	
---	--	--

INSTRUCTIONS: Use typewriter or ball point pen. Please press firmly and print clearly. Please fill in blanks, underline or circle the correct answers. Send top three copies to Kansas Department of Health and Environment, Bureau of Water, Geology Section, 1000 SW Jackson St., Ste. 420, Topeka, Kansas 66612-1367. Telephone: 785/296-5522. Send one to Water Well Owner and retain one for your records.