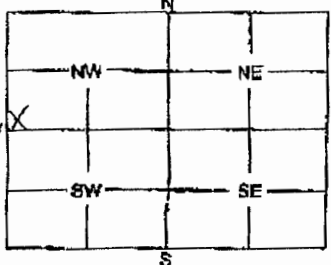


MW-3

WATER WELL PLUGGING RECORD Form WWC-5P KSA 82a-1212 ID NO. _____

1	LOCATION OF WATER WELL:	Fraction	Section Number	Township Number	Range Number																											
	County: <u>Saline</u>	<u>SW 1/4 SW 1/4 NW 1/4</u>	<u>36</u>	<u>14 S</u>	<u>3 W</u> E/W																											
Distance and direction from nearest town or city street address of well if located within city? <u>2629 S. Market Place, Salina, KS</u>																																
2	WATER WELL OWNER: <u>Kwik Shop</u>																															
RR #, St. Address, Box #: City, State, ZIP Code:			Board of Agriculture, Division of Water Resources Application Number:																													
3	MARK WELL'S LOCATION WITH AN "X" IN SECTION BOX:																															
																																
4	DEPTH OF WELL <u>30</u> ft.																															
WELL'S STATIC WATER LEVEL <u>24.05</u> ft.																																
WELL WAS USED AS:																																
<table style="width:100%;"> <tr> <td>1 Domestic</td> <td>5 Public Water Supply</td> <td>9 Dewatering</td> </tr> <tr> <td>2 Irrigation</td> <td>6 Oil Field Water Supply</td> <td>10 Monitoring Well</td> </tr> <tr> <td>3 Feedlot</td> <td>7 Domestic (Lawn & Garden)</td> <td>11 Injection Well</td> </tr> <tr> <td>4 Industrial</td> <td>8 Air Conditioning</td> <td>12 Other</td> </tr> </table>						1 Domestic	5 Public Water Supply	9 Dewatering	2 Irrigation	6 Oil Field Water Supply	10 Monitoring Well	3 Feedlot	7 Domestic (Lawn & Garden)	11 Injection Well	4 Industrial	8 Air Conditioning	12 Other															
1 Domestic	5 Public Water Supply	9 Dewatering																														
2 Irrigation	6 Oil Field Water Supply	10 Monitoring Well																														
3 Feedlot	7 Domestic (Lawn & Garden)	11 Injection Well																														
4 Industrial	8 Air Conditioning	12 Other																														
Was a chemical / bacteriological sample submitted to Department? Yes _____ No <u>X</u>																																
If yes, mo/day/yr sample was submitted _____																																
Water Well Disinfected: Yes _____ No <u>X</u>																																
5	TYPE OF BLANK CASING USED:																															
<table style="width:100%;"> <tr> <td>1 Steel</td> <td>3 RMP (SR)</td> <td>5 Wrought</td> <td>7 Fiberglass</td> <td>9 Other (Specify below)</td> </tr> <tr> <td>2 PVC</td> <td>4 ABS</td> <td>6 Asbestos-Cement</td> <td>8 Concrete Tile</td> <td></td> </tr> </table>						1 Steel	3 RMP (SR)	5 Wrought	7 Fiberglass	9 Other (Specify below)	2 PVC	4 ABS	6 Asbestos-Cement	8 Concrete Tile																		
1 Steel	3 RMP (SR)	5 Wrought	7 Fiberglass	9 Other (Specify below)																												
2 PVC	4 ABS	6 Asbestos-Cement	8 Concrete Tile																													
Blank casing diameter <u>2</u> in. Was casing pulled? Yes <u>X</u> No _____ If yes, how much <u>5 ft</u>																																
Casing height above or below land surface <u>5 feet</u>																																
6	GROUT PLUG MATERIAL:																															
<table style="width:100%;"> <tr> <td>1 Neat cement</td> <td>2 Cement grout</td> <td>3 Bentonite</td> <td>4 Other</td> </tr> </table>						1 Neat cement	2 Cement grout	3 Bentonite	4 Other																							
1 Neat cement	2 Cement grout	3 Bentonite	4 Other																													
Grout Plug Intervals: From <u>30</u> ft. to <u>3</u> ft. From _____ ft. to _____ ft. From _____ ft. to _____ ft.																																
What is the nearest source of possible contamination:																																
<table style="width:100%;"> <tr> <td>1 Septic tank</td> <td>6 Seepage pit</td> <td>11 Fuel storage</td> </tr> <tr> <td>2 Sewer lines</td> <td>7 Pit privy</td> <td>12 Fertilizer storage</td> </tr> <tr> <td>3 Watertight sewer lines</td> <td>8 Sewage lagoon</td> <td>13 Insecticide storage</td> </tr> <tr> <td>4 Lateral lines</td> <td>9 Foodyard</td> <td>14 Abandoned water well</td> </tr> <tr> <td>5 Cess pool</td> <td>10 Livestock pens</td> <td>15 Oil well/Gas well</td> </tr> </table>						1 Septic tank	6 Seepage pit	11 Fuel storage	2 Sewer lines	7 Pit privy	12 Fertilizer storage	3 Watertight sewer lines	8 Sewage lagoon	13 Insecticide storage	4 Lateral lines	9 Foodyard	14 Abandoned water well	5 Cess pool	10 Livestock pens	15 Oil well/Gas well												
1 Septic tank	6 Seepage pit	11 Fuel storage																														
2 Sewer lines	7 Pit privy	12 Fertilizer storage																														
3 Watertight sewer lines	8 Sewage lagoon	13 Insecticide storage																														
4 Lateral lines	9 Foodyard	14 Abandoned water well																														
5 Cess pool	10 Livestock pens	15 Oil well/Gas well																														
Direction from well? <u>NW</u> How many feet? <u>40 ft</u>																																
<table border="1" style="width:100%; border-collapse: collapse;"> <thead> <tr> <th>FROM</th> <th>TO</th> <th>PLUGGING MATERIALS</th> </tr> </thead> <tbody> <tr> <td><u>30'</u></td> <td><u>3'</u></td> <td><u>Bentonite</u></td> </tr> <tr> <td><u>3'</u></td> <td><u>1'</u></td> <td><u>Sand</u></td> </tr> <tr> <td><u>1'</u></td> <td><u>0'</u></td> <td><u>Concrete</u></td> </tr> <tr><td> </td><td> </td><td> </td></tr> <tr><td> </td><td> </td><td> </td></tr> <tr><td> </td><td> </td><td> </td></tr> <tr><td> </td><td> </td><td> </td></tr> <tr><td> </td><td> </td><td> </td></tr> </tbody> </table>						FROM	TO	PLUGGING MATERIALS	<u>30'</u>	<u>3'</u>	<u>Bentonite</u>	<u>3'</u>	<u>1'</u>	<u>Sand</u>	<u>1'</u>	<u>0'</u>	<u>Concrete</u>															
FROM	TO	PLUGGING MATERIALS																														
<u>30'</u>	<u>3'</u>	<u>Bentonite</u>																														
<u>3'</u>	<u>1'</u>	<u>Sand</u>																														
<u>1'</u>	<u>0'</u>	<u>Concrete</u>																														
7	CONTRACTOR'S OR LANDOWNER'S CERTIFICATION: This water well was plugged under my jurisdiction and was completed on (mo/day/year) <u>10-13-08</u> and this record is true to the best of my knowledge and belief. Kansas Water Well Contractor's License No. <u>228</u> This Water Well Record was completed on (mo/day/year) <u>10-13-08</u> under the business name of <u>J.C. Drilling & Seal</u> by (signature) <u>[Signature]</u>																															
INSTRUCTIONS: Use typewriter or ball point pen. Please press firmly and print clearly. Please fill in blanks, underline or circle the correct answers. Send top three copies to Kansas Department of Health and Environment, Bureau of Water, Geology Section, 1000 SW Jackson St., Ste. 420, Topeka, Kansas 66612-1367. Telephone: 785/296-5522. Send one to Water Well Owner and retain one for your records.																																