

CORRECTION(S) TO WATER WELL RECORD (WWC-5)

(to rectify lacking or incorrect information)

County: Saline

Location listed as:

Section-Township-Range: 11-14S-3W

Fraction ($\frac{1}{4}$ $\frac{1}{4}$ $\frac{1}{4}$): NW NE SW

Location changed to:

14-14S-3W

NE SW NE NW

Other changes: Initial statements: _____

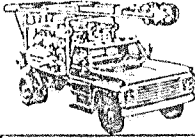
Changed to: _____

Comments: _____

verification method: Wellsite location shown on sketch map, city street map, and mapping tool on KGS website.

initials: DRf date: 12/21/2011

submitted by: Kansas Geological Survey, Data Resources Library, 1930 Constant Ave., Lawrence, KS 66047-3726
to: Kansas Dept of Health & Environment, Bureau of Water, 1000 SW Jackson, Suite 420, Topeka, KS 66612-1367.

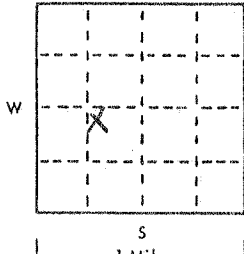
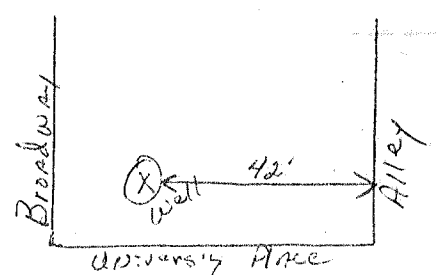


Pestinger Drilling Company

1711 North Fifth Street / Salina, Kansas 67401 / Telephone 913 825-1932

State License No. 328

Date Sent 6-1-77

1 Location of well:	County SALINE	Township name LEAVENWORTH	Fraction N 1/4 NE 1/4 SW 1/4	Section number 11	Town number T145	Range number R3W																																							
Distance and direction from nearest town or city: CITY LIMITS				3 Owner of well: LAMPTON WELDING SUPPLY	
Street address of well location if in city:				Address: 522 N 9th SALINA, KS. 67401	
Locate with "X" in section below: N  S 1 Mile		Sketch map: 		4 Well depth: 84 ft. Date of completion: 5-21-79 Well diameter: 8 in.	
				5 ☐ Cable tool ☒ Rotary ☐ Driven ☐ Dug ☐ Hollow rod ☐ Jetted ☐ Bored ☐ Reverse rotary	
				6 Use: ☐ Domestic ☐ Public supply ☐ Industry ☐ Irrigation ☒ Air conditioning ☐ Commercial ☐ Test well ☐	
				7 Casing: Material RMP Height: above 265 ft. Threaded ☐ Welded ☐ Surface 84 in. Diam. 5 in. Weight 200 lbs./ft. to 84 ft. depth Drive shoe? ☐ Yes ☒ No	
<table border="1" style="width:100%; border-collapse: collapse;"> <tr> <th>2</th> <th>Type and color of material</th> <th>From</th> <th>To</th> </tr> <tr> <td></td> <td>TOPSOIL</td> <td>0</td> <td>8</td> </tr> <tr> <td></td> <td>Clay L brown</td> <td>8</td> <td>21</td> </tr> <tr> <td></td> <td>Clay Red</td> <td>21</td> <td>30</td> </tr> <tr> <td></td> <td>Clay Sandy Redish Brown</td> <td>30</td> <td>57</td> </tr> <tr> <td></td> <td>Sand L brown water bearing</td> <td>57</td> <td>60</td> </tr> <tr> <td></td> <td>Clay brown</td> <td>60</td> <td>63</td> </tr> <tr> <td></td> <td>Sand brown & black 1/4 - 1/2 (creek Gravel)</td> <td>63</td> <td>84</td> </tr> <tr> <td></td> <td></td> <td></td> <td></td> </tr> <tr> <td></td> <td></td> <td></td> <td></td> </tr>5" Slot/gauze 1/8 Length 10' Set between 74 ft. and 84 ft. Fittings: Gravel pack ☒ Yes ☐ No Size range of material 4		
9 Static water level: 22 ft. below land surface Date 5-21-79	
10 Pumping level below land surfaces: 26 ft. after 1 1/2 hrs. pumping 60 g.p.m. ft. after _____ hrs. pumping _____ g.p.m. Estimated maximum yield 150 g.p.m.	
11 Water sample submitted: ☐ Yes ☒ No Date _____	
12 Well head completion: ☐ Pitless adapter ☐ Inches above grade	
13 Well grouted? ☒ Yes ☐ No ☒ Neat cement ☐ Bentonite ☐ Depth: From 0 ft. to 10 ft.	
14 Nearest source of possible contamination: ft. 45 Direction East Type Sewer Well disinfected upon completion? ☒ Yes ☐ No	
15 Pump: ☒ Not installed Manufacturer's name _____ Model number _____ HP _____ Volts _____ Length of drop pipe _____ ft. capacity _____ g.p.m. Type: ☐ Submersible ☐ Turbine ☐ Jet ☐ Reciprocating ☐ Centrifugal ☐ Other	
16 Remarks: elevation WELL TO BE USED FOR WATER COOLED HEAT PUMPS, NOT FOR HUMAN CONSUMPTION	
17 Water well contractor's certification: This well was drilled under my jurisdiction and this report is true to the best of my knowledge and belief. Pestinger Drilling Co. Business name _____ License No. 328 Address Salina, Ks. Signed <i>[Signature]</i> Date 5-23-79 Authorized representative	

14 BLU 11 NW NE SW