GSI Job No. 117409 **MW-FG-12D**

WATER WELL RECORD Form WWC-5 KSA 82a-1212 ID No. _____

1 LOCATION OF WATER WELL:	Fraction	Section Number	Township Number	Range Number
County: **Saline**	**SW** ¼ **NW** ¼ **SW** ¼	**12**	T **14** S	R **3** W

Distance and direction from nearest town or city street address of well if located within city?
353 N. 7th St. – Salina

2 WATER WELL OWNER: **Union Pacific Railroad Company**
RR#, St. Address, Box # : **1400 Douglas St., Mail Stop 1030**
City, State, ZIP Code : **Omaha, NE 68179-1030**

Board of Agriculture, Division of Water Resources
Application Number:

3 LOCATE WELL'S LOCATON WITH AN "X" IN SECTION BOX:

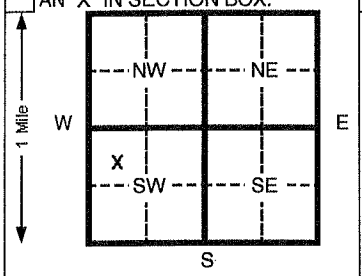

4 DEPTH OF COMPLETED WELL **50** ft. ELEVATION: _____

Depth(s) Groundwater Encountered 1 _____ ft. 2 _____ ft. 3 _____ ft.

WELL'S STATIC WATER LEVEL **30** ft. below land surface measured on mo/day/yr _____

Pump test data: Well water was _____ ft. after _____ hours pumping _____ gpm

Est. Yield _____ gpm: Well water was _____ ft. after _____ hours pumping _____ gpm

Bore Hole Diameter **8.25** in. to **50** ft. and _____ in. to _____ ft.

WELL WATER TO BE USED AS: 1 Domestic 2 Irrigation 3 Feed lot 4 Industrial 5 Public water supply 6 Oil field water supply 7 Lawn and garden (domestic) 8 Air conditioning 9 Dewatering 10 Monitoring well 11 Injection well 12 Other (Specify below) _____

Was a chemical/bacteriological sample submitted to Department? Yes _____ No **X** If yes, mo/day/yr sample was submitted _____ Water Well Disinfected? Yes _____ No **X**

5 TYPE OF BLANK CASING USED: 1 Steel 2 PVC 3 RMP (SR) 4 ABS 5 Wrought Iron 6 Asbestos-Cement 7 Fiberglass 8 Concrete tile 9 Other (specify below) _____

CASING JOINTS: Glued _____ Clamped _____ Welded _____ Threaded **Flush**

Blank casing diameter **2** in. to **45** ft., Dia _____ in. to _____ ft., Dia _____ in. to _____ ft.

Casing height above land surface **0** in., weight **0.703** lbs./ft. Wall thickness or gauge No. **SCH. 40**

TYPE OF SCREEN OR PERFORATION MATERIAL: 1 Steel 2 Brass 3 Stainless steel 4 Galvanized steel 5 Fiberglass 6 Concrete tile 7 PVC 8 RMP (SR) 9 ABS 10 Asbestos-cement 11 Other (specify) _____ 12 None used (open hole)

SCREEN OR PERFORATION OPENINGS ARE: 1 Continuous slot 2 Louvered shutter 3 Mill slot 4 Key punched 5 Gauzed wrapped 6 Wire wrapped 7 Torch cut 8 Saw cut 9 Drilled holes 10 Other (specify) _____ 11 None (open hole)

SCREEN-PERFORATED INTERVALS: From **45** ft. to **50** ft. From _____ ft. to _____ ft.
From _____ ft. to _____ ft. From _____ ft. to _____ ft.

GRAVEL PACK INTERVALS: From **43** ft. to **50** ft. From _____ ft. to _____ ft.
From _____ ft. to _____ ft. From _____ ft. to _____ ft.

6 GROUT MATERIAL: 1 Neat cement 2 Cement grout 3 Bentonite 4 Other _____

Grout Intervals From **0.5** ft. to **43** ft. From _____ ft. to _____ ft. From _____ ft. to _____ ft.

What is the nearest source of possible contamination:
1 Septic tank 2 Sewer lines 3 Watertight sewer lines 4 Lateral lines 5 Cess pool 6 Seepage pit 7 Pit privy 8 Sewage lagoon 9 Feedyard 10 Livestock pens 11 Fuel storage 12 Fertilizer storage 13 Insecticide storage 14 Abandoned water well 15 Oil well/ Gas well 16 Other (specify below) _____

Direction from well? How many feet?

FROM	TO	CODE	LITHOLOGIC LOG	FROM	TO	PLUGGING INTERVALS
0	20		**Silt, brown to light brown, with some clay**			
20	27.5		**Clayey Silt, light brown**			
27.5	30		**Silty Clay, light brown**			
30	40		**Sand, fine to medium grained, brown**			
40	50		**Sand, fine to coarse grained, brown**			
						GPS:
						Latitude: 38°50'48.74"N
						Longitude: 97°36'37.27"W

7 CONTRACTOR'S OR LANDOWNER'S CERTIFICATION: This water well was (1) constructed, (2) reconstructed, or (3) plugged under my jurisdiction and was completed on (mo/day/yr) **12/14/11** and this record is true to the best of my knowledge and belief. Kansas Water Well Contractor's License No. **531** This Water Well Record was completed on (mo/day/yr) **01/06/12** under the business name of **Geotechnical Services Inc.** by (signature)

INSTRUCTIONS:. Please fill in blanks and circle the correct answers. Send three copies to Kansas Department of Health and Environment, Bureau of Water, 1000 S W Jackson St., Ste. 420, Topeka, Kansas 66612-1367. Telephone: 913-296-5545. Send one to WATER WELL OWNER and retain one for your records.

OFFICE USE ONLY T R SEC

White CopyWhite Copy Form provided by Forms-On-A-Disk, Inc. · Dallas, Texas · (214) 340-9429