


~20 east of 1332 W North St., Salina, KS

4 DEPTH OF COMPLETED WELL		25 ft.		ELEVATION:		1231.82	
Depth(s) Groundwater Encountered		1.5	20	ft.	2	ft.	3
WELL'S STATIC WATER LEVEL		19.58		ft. below land surface measured on		07/05/12	
Pump test data:		Well water was		Ft. after		hours pumping	
Est. Yield		Gpm:		Well water was		Ft. after	
						Hours pumping	
Bore Hole Diameter		8.625		In. to		25	
						ft. and	
						in. to	
WELL WATER TO BE USED AS:		5 Public water supply		8 Air conditioning		11 Injection well	
1 Domestic		3 Feed lot		6 Oil field water supply		9 Dewatering	
2 Irrigation		4 Industrial		7 Lawn and garden (domestic)		10 Monitoring well	
						MW-25	
Was a chemical/bacteriological sample submitted to Department? Yes No <input checked="" type="checkbox"/> If yes, mo/day/yr sample was							
Submitted Water Well Disinfected? Yes No <input checked="" type="checkbox"/>							

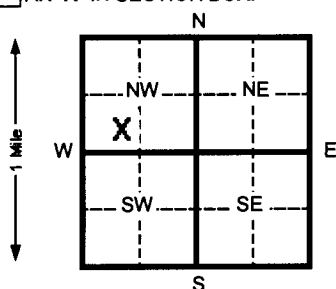

OFFICE USE ONLY

T

२

SEC