

WATER WELL PLUGGING RECORD Form WWC-5P

KSA 82a-1212

ID NO.

1 LOCATION OF WATER WELL: Fraction $\frac{1}{4}$ SW $\frac{1}{4}$ SW $\frac{1}{4}$ SW $\frac{1}{4}$ Section Number 4 Township Number T 14 S Range Number 3 ☐ E ☒ W

Street/Rural Address of Well Location; if unknown, distance & direction from nearest town or intersection: If at owner's address, check here ☐ Bunge Salina Elevator

1112 North Halstead Rd.
Salina, KS 67401

Global Positioning Systems (GPS) information:

Latitude: 38.856267 (in decimal degrees)

Longitude: 97.667994 (in decimal degrees)

Elevation: 1251

Datum: ☐ WGS84, ☒ NAD83, ☐ NAD27

Collection Method:


2 WATER WELL OWNER: Bunge North America, Inc.

RR#, St. Address, Box #: PO Box 28500

City, State ZIP Code: St. Louis, MO 63146

☐ GPS unit (Make/Model):☐ Digital Map/Photo, ☐ Topographic Map, ☒ Land SurveyEst. Accuracy: ☒ < 3 m, ☐ 3-5 m, ☐ 5-15 m, ☐ > 15 m

3 MARK WELL'S LOCATION WITH AN "X" IN SECTION BOX:

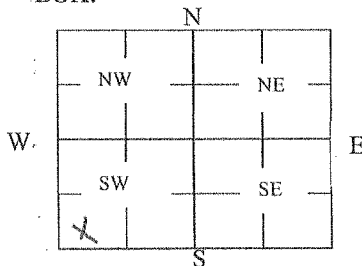

4 DEPTH OF WELL 35.84 ft.

WELL'S STATIC WATER LEVEL 21.51 ft

WELL WAS USED AS:

☐ Domestic
☐ Irrigation
☐ Feedlot
☐ Industrial

☐ Public Water Supply
☐ Oil Field Water Supply
☐ Domestic (Lawn & Garden)
☐ Air Conditioning

☐ Dewatering
☒ Monitoring
☐ Injection Well
☐ Other PZ-2
Was a chemical/bacteriological sample submitted to Department? Yes ☐ No ☒

5 TYPE OF BLANK CASING USED:

☐ Steel
☒ PVC

☐ RMP (SR)
☐ ABS

☐ Wrought
☐ Asbestos-Cement

☐ Fiberglass
☐ Concrete Tile
☐ Other (Specify below)

Blank casing diameter 1 in. Was casing pulled? Yes ☒ No ☐ If yes, how much _____
 Casing height above or below land surface 30 in.

6 GROUT PLUG MATERIAL:

☐ Neat cement☐ Cement grout☒ Bentonite☒ Other 0-6" Top Soil

Grout Plug Intervals: From 0.5 ft. to 35.84 ft., From N/A ft. to N/A ft., From N/A to N/A ft.

What is the nearest source of possible contamination:

☐ Septic tank
☐ Sewer lines
☐ Watertight sewer lines
☐ Lateral lines
☐ Cess pool

☐ Seepage pit
☐ Pit privy
☐ Sewage lagoon
☐ Feedyard
☐ Livestock pens

☐ Fuel Storage
☐ Fertilizer storage
☐ Insecticide storage
☐ Abandoned water well
☐ Oil well/Gas well
☒ Other (specify below)

Grain Elevator

Direction from well? NW

How many feet? < 200'

FROM	TO	PLUGGING MATERIALS	FROM	TO	PLUGGING MATERIALS
0	0.5'	Top Soil			
0.5'	35.84'	Bentonite			

7 CONTRACTOR'S OR LANDOWNER'S CERTIFICATION: This water well was plugged under my jurisdiction and was completed on (mo/day/year) 1-2-13 and this record is true to the best of my knowledge and belief. Kansas Water Well Contractor's License No. 759. This Water Well Record was completed on (mo/day/year) 1-24-13 under the business name of RAZEK Environmental, LLC by (signature) [Signature]

INSTRUCTIONS: Use typewriter or ballpoint pen. Please press firmly and print clearly. Please fill in blanks, underline or circle the correct answers. Send top three copies to Kansas Department of Health and Environment, Bureau of Water, Geology Section, 1000 SW Jackson St., Ste. 420, Topeka, Kansas 66612-1367. Telephone: 785/296-5524. Send one to Water Well Owner and retain one for your records. Visit us at <http://www.kdheks.gov/waterwell/index.html>.

Check one:

☐ White Copy☐ Blue Copy☐ Pink Copy