

WATER WELL RECORD

Form WWC-5


Division of Water Resources App. No.

1 LOCATION OF WATER WELL: County: Saline	Fraction NE ¼ NW ¼ NE ¼ NW ¼	Section Number 14	Township No. T 14 S	Range Number R 3 <input type="checkbox"/> E <input checked="" type="checkbox"/> W
--	---------------------------------	----------------------	------------------------	--

Street/Rural Address of Well Location; if unknown, distance & direction from nearest town or intersection: If at owner's address, check here .
 Prime Time #123
 100 North Broadway, Salina, KS 67401

Global Positioning System (GPS) information:
 Latitude: 38.840628 (in decimal degrees)
 Longitude: 97.624586 (in decimal degrees)
 Elevation: 1222.72
 Datum: WGS 84, NAD 83, NAD 27
 Collection Method:
 GPS unit (Make/Model: _____)
 Digital Map/Photo, Topographic Map, Land Survey
 Est. Accuracy: <3 m, 3-5 m, 5-15 m, >15 m

2 WATER WELL OWNER: Primetime Stores of Kansas
 RR#, Street Address, Box #: PO Box 1720
 City, State, ZIP Code : Forsyth, MO 65653

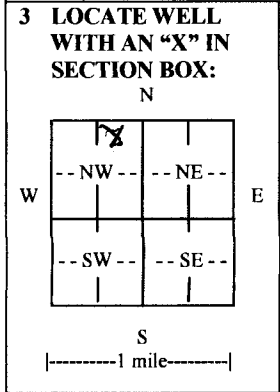

4 DEPTH OF COMPLETED WELL 35 ft.
 Depth(s) Groundwater Encountered (1) 19 ft. (2) N/A ft. (3) N/A ft.
 WELL'S STATIC WATER LEVEL 19.48 ft. below land surface measured on mo/day/yr. 3-20-14
 Pump test data: Well water was N/A ft. after N/A hours pumping. N/A gpm
 EST. YIELD. N/A gpm. Well water was N/A ft. after N/A hours pumping. N/A gpm
 Bore Hole Diameter 10.62 in. to 35 ft., and N/A in. to N/A ft.
 WELL WATER TO BE USED AS: Public water supply Geothermal Injection well
 Domestic Feedlot Oil field water supply Dewatering Other (Specify below)
 Irrigation Industrial Domestic-lawn & garden Monitoring well MW-4
 Was a chemical/bacteriological sample submitted to Department? Yes No
 If yes, mo/day/yr sample was submitted N/A
 Water well disinfected? Yes No

5 TYPE OF CASING USED: Steel PVC Other _____
 CASING JOINTS: Glued Clamped Welded Threaded
 Casing diameter 4 in. to 15 ft., Diameter N/A in. to N/A ft., Diameter N/A in. to N/A ft.
 Casing height above land surface 0 in., Weight N/A lbs./ft., Wall thickness or gauge No. Schedule 40
 TYPE OF SCREEN OR PERFORATION MATERIAL:
 Steel Stainless Steel PVC Other (Specify) _____
 Brass Galvanized Steel None used (open hole)
 SCREEN OR PERFORATION OPENINGS ARE:
 Continuous slot Mill slot Gauze wrapped Torch cut Drilled holes None (open hole)
 Louvered shutter Key punched Wire wrapped Saw cut Other (specify) _____
 SCREEN-PERFORATED INTERVALS: From 15 ft. to 35 ft., From N/A ft. to N/A ft., From N/A ft. to N/A ft.
 From N/A ft. to N/A ft., From N/A ft. to N/A ft., From N/A ft. to N/A ft.
 GRAVEL PACK INTERVALS: From 13 ft. to 35 ft., From N/A ft. to N/A ft., From N/A ft. to N/A ft.
 From N/A ft. to N/A ft., From N/A ft. to N/A ft., From N/A ft. to N/A ft.

6 GROUT MATERIAL: Neat cement Cement grout Bentonite Other Concrete 0 to 2-feet
 Grout Intervals: From 2 ft. to 13 ft., From N/A ft. to N/A ft., From N/A ft. to N/A ft.
 What is the nearest source of possible contamination:
 Septic tank Lateral lines Pit privy Livestock pens Insecticide storage Other (specify below)
 Sewer lines Cesspool Sewage lagoon Fuel storage Abandoned water well
 Watertight sewer lines Seepage pit Feedyard Fertilizer storage Oil well/gas well
 Direction from well North Distance from well <25-feet

FROM	TO	LITHOLOGIC LOG	FROM	TO	LITHO. LOG (cont.) or PLUGGING INTERVALS
0	0.5	4" Concrete, 2" Sand	17	19.5	Silty CLAY gray slightly moist
0.5	5.5	Silty CLAY, dark brown, slightly moist medium stiff plastic	19.5	22.0	CLAY brown slightly moist stiff highly plastic
5.5	8.0	Silty CLAY grayish brown slightly moist medium stiff plastic	22.0	25.0	Clayey SILT reddish brown very moist soft medium plastic
8.0	8.5	Silty CLAY grayish brown moist soft	25.0	35.0	Clayey SILT reddish brown saturated very soft medium plastic
8.5	14.5	CLAY dark gray slightly moist medium stiff to stiff highly plast.			
14.5	17	CLAY gray to greenish gray slightly moist medium stiff plastic			

7 CONTRACTOR'S OR LANDOWNER'S CERTIFICATION: This water well was constructed, reconstructed, or plugged under my jurisdiction and was completed on (mo/day/year) 3-17-2014 and this record is true to the best of my knowledge and belief. Kansas Water Well Contractor's License No. 759 This Water Well Record was completed on (mo/day/year) 4-29-2014 under the business name of RAZEK Environmental, LLC by (signature) *[Signature]*

INSTRUCTIONS: Use typewriter or ball point pen. PLEASE PRESS FIRMLY and PRINT clearly. Please fill in blanks and check the correct answers. Send one copy to Kansas Department of Health and Environment, Bureau of Water, Geology Section, 1000 SW Jackson St., Suite 420, Topeka, Kansas 66612-1367. Telephone 785-296-5524. Send one copy to WATER WELL OWNER and retain one for your records. Include fee of \$5.00 for each constructed well. Visit us at <http://www.kdheks.gov/waterwell/index.html>