

WATER WELL RECORD ~~KS-07~~ **Form WWC-5**

Division of Water Resources App. No.


1 LOCATION OF WATER WELL: Fraction SE 1/4 SW 1/4 NW 1/4 1/4 Section Number 12 Township No. T 14 S Range Number R 3 E W
 County: SALINE

Street/Rural Address of Well Location; if unknown, distance & direction from nearest town or intersection: If at owner's address, check here
501 N. SANTE FE
SALINA KS 67401

Global Positioning System (GPS) information:
 Latitude: 38° 50' 56" N (in decimal degrees)
 Longitude: 97° 36' 34" W (in decimal degrees)
 Elevation: 1222'
 Datum: WGS 84, NAD 83, NAD 27

2 WATER WELL OWNER: MATADOR CATTLE CO.
 RR#, Street Address, Box #: 4111 E. 37th ST. NORTH
 City, State, ZIP Code: WICHITA, KS 67220

Collection Method:
 GPS unit (Make/Model:)
 Digital Map/Photo, Topographic Map, Land Survey
 Est. Accuracy: <3 m, 3-5 m, 5-15 m, >15 m

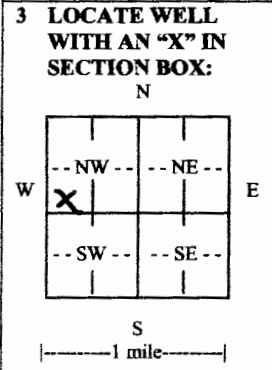

4 DEPTH OF COMPLETED WELL 30' ft.
 Depth(s) Groundwater Encountered (1)..... ft. (2)..... ft. (3)..... ft.
 WELL'S STATIC WATER LEVEL..... ft. below land surface measured on mo/day/yr.
 Pump test data: Well water was..... ft. after..... hours pumping..... gpm
 EST. YIELD..... gpm. Well water was..... ft. after..... hours pumping..... gpm
 Bore Hole Diameter 8" in. to 30' ft., and..... in. to..... ft.
 WELL WATER TO BE USED AS: Public water supply Geothermal Injection well
 Domestic Feedlot Oil field water supply Dewatering Other (Specify below)
 Irrigation Industrial Domestic-lawn & garden Monitoring well EXTRACTION
 Was a chemical/bacteriological sample submitted to Department? Yes No
 If yes, mo/day/yr sample was submitted.....
 Water well disinfected? Yes No

5 TYPE OF CASING USED: Steel PVC Other STAINLESS STEEL
 CASING JOINTS: Glued Clamped Welded Threaded

Casing diameter 4" in. to 5' ft., Diameter..... in. to..... ft., Diameter..... in. to..... ft.
 Casing height above land surface 24" in., Weight..... lbs./ft., Wall thickness or gauge No. 304

TYPE OF SCREEN OR PERFORATION MATERIAL:
 Steel Stainless Steel PVC Other (Specify).....
 Brass Galvanized Steel None used (open hole)

SCREEN OR PERFORATION OPENINGS ARE:
 Continuous slot Mill slot Gauze wrapped Torch cut Drilled holes None (open hole)
 Louvered shutter Key punched Wire wrapped Saw cut Other (specify).....

SCREEN-PERFORATED INTERVALS: From 5' ft. to 30' ft., From..... ft. to..... ft.
 From..... ft. to..... ft., From..... ft. to..... ft.

GRAVEL PACK INTERVALS: From 3' ft. to 30' ft., From..... ft. to..... ft.
 From..... ft. to..... ft., From..... ft. to..... ft.

6 GROUT MATERIAL: Neat cement Cement grout Bentonite Other CLASS H / SILICA FLOUR GROUT
 Grout Intervals: From 0' ft. to 3' ft., From..... ft. to..... ft., From..... ft. to..... ft.

What is the nearest source of possible contamination:
 Septic tank Lateral lines Pit privy Livestock pens Insecticide storage Other (specify below)
 Sewer lines Cesspool Sewage lagoon Fuel storage Abandoned water well
 Watertight sewer lines Seepage pit Feedyard Fertilizer storage Oil well/gas well N/A
 Direction from well..... Distance from well.....

FROM	TO	LITHOLOGIC LOG	FROM	TO	LITHO. LOG (cont.) or PLUGGING INTERVALS
0'	6"	CONCRETE			
6"	27'	BROWN SALT CLAY / CLAY			
27'	30'	SAND			

7 CONTRACTOR'S OR LANDOWNER'S CERTIFICATION: This water well was constructed, reconstructed, or plugged under my jurisdiction and was completed on (mo/day/year) 9/11/2014 and this record is true to the best of my knowledge and belief.
 Kansas Water Well Contractor's License No. 793 This Water Well Record was completed on (mo/day/year) 9/24/14
 under the business name of Candy Pump Service by (signature) [Signature]

INSTRUCTIONS: Use typewriter or ball point pen. PLEASE PRESS FIRMLY and PRINT clearly. Please fill in blanks and check the correct answer. Send one copy to Kansas Department of Health and Environment, Bureau of Water, Geology Section, 1000 SW Jackson St., Suite 425, Topeka, Kansas 66612-1367. Telephone 785-296-5524. Send one copy to WATER WELL OWNER and retain one for your records. Include fee of \$5.00 for each constructed well. Visit us at <http://www.krhhs.gov/waterwell/index.html>

