


1	LOCATION OF WATER WELL:	Fraction	Section Number	Township Number	Range Number
County:	Saline	NW 1/4 NE 1/4 NW 1/4	14	14	3E EW

Distance and direction from nearest town or city street address of well if located within city?  
 100 North Broadway, Salina, KS

2	WATER WELL OWNER: Dick Young	Board of Agriculture, Division of Water Resources
	RR #, St. Address, Box #: P.O. Box 1720	Application Number:
	City, State, ZIP Code: Forsyth, MO 65653	

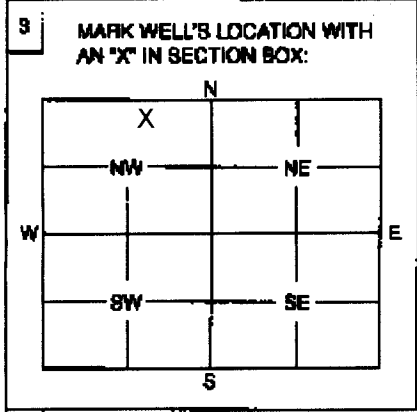

4	DEPTH OF WELL <u>27</u> ft.
	WELL'S STATIC WATER LEVEL..... ft.
	WELL WAS USED AS:
	1 Domestic                      5 Public Water Supply                      9 Dewatering 2 Irrigation                      6 Oil Field Water Supply                      10 Monitoring Well 3 Feedlot                      7 Domestic (Lawn & Garden)                      11 Injection Well 4 Industrial                      8 Air Conditioning                      12 Other.....
	Was a chemical / bacteriological sample submitted to Department? Yes..... No <u>X</u> .....
	If yes, mo/day/yr sample was submitted.....
	Water Well Disinfected: Yes..... No <u>X</u> .....

5	TYPE OF BLANK CASING USED:
	1 Steel                      3 RMP (SR)                      5 Wrought                      7 Fiberglass                      9 Other (Specify below) 2 PVC                      4 ABS                      6 Asbestos-Cement                      8 Concrete Tile
	Blank casing diameter <u>4</u> in.                      Was casing pulled? Yes <u>X</u> No.....                      If yes, how much full length.....
	Casing height above or below land surface <u>6 below</u> in.

6	GROUT PLUG MATERIAL: 1 Neat cement                      2 Cement grout                      3 Bentonite                      4 Other.....
	GROUT PLUG INTERVALS: From <u>3</u> ft. to <u>27</u> ft.                      From..... ft. to..... ft.                      From..... to.....
	What is the nearest source of possible contamination:
	1 Septic tank                      6 Seepage pit                      11 Fuel storage                      16 Other (specify below) 2 Sewer lines                      7 Pit privy                      12 Fertilizer storage 3 Watertight sewer lines                      8 Sewage lagoon                      13 Insecticide storage 4 Lateral lines                      9 Feedyard                      14 Abandoned water well 5 Cess pool                      10 Livestock pens                      15 Oil well/Gas well
	Direction from well? <u>North</u> How many feet? <u>50</u>

FROM	TO	PLUGGING MATERIALS
0	3	Clay
3	27	Hydrated bentonite chips

7	CONTRACTOR'S OF LANDOWNER'S CERTIFICATION: This water well was plugged under my jurisdiction and was completed on (mo/day/year) <u>3/17/15</u> and this record is true to the best of my knowledge and belief. Kansas Water Well Contractor's License No. <u>708</u> This Water Well Record was completed on (mo/day/year) <u>3/26/15</u> under the business name of <u>SCS Aquaterra</u> by (signature) <u>[Signature]</u>
---	---

INSTRUCTIONS: Use typewriter or ball point pen. Please press firmly and print clearly. Please fill in blanks, underline or circle the correct answers. Send top three copies to Kansas Department of Health and Environment, Bureau of Water, Geology Section, 1000 SW Jackson St., Ste. 420, Topeka, Kansas 66612-1367. Telephone: 785/296-5522. Send one to Water Well Owner and retain one for your records.