


1 LOCATION OF WATER WELL:	Fraction	Section Number	Township Number	Range Number
County: <u>SALINE</u>	<u>SE 1/4 SE 1/4 SE 1/4</u>	<u>23</u>	<u>T 14 S</u>	<u>R 8 E</u>

Distance and direction from nearest town or city street address of well if located within city?

80' N of intersection of 9th St & Woodlawn

2 WATER WELL OWNER: <u>KDHE</u>	Board of Agriculture, Division of Water Resources
RR#, St. Address, Box #: <u>Forbes Field Bldg. 740</u>	Application Number:
City, State, ZIP Code: <u>Topeka KS 66620</u>	

3 LOCATE WELL'S LOCATION WITH AN "X" IN SECTION BOX:	4 DEPTH OF COMPLETED WELL: <u>40'</u> ft. ELEVATION: <u>1233.86</u> M.W. <u>12</u>
--	--

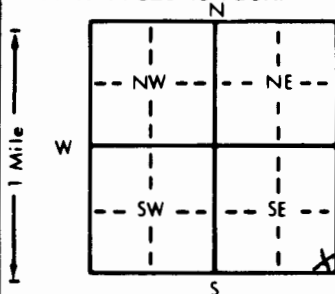

Depth(s) Groundwater Encountered 1. ft. 2. ft. 3. ft.

WELL'S STATIC WATER LEVEL 24.79 ft. below land surface measured on mo/day/yrPump test data: Well water was NA ft. after hours pumping gpm

Est. Yield gpm: Well water was ft. after hours pumping gpm

Bore Hole Diameter 8 in. to 40' ft., and in. to ft.

WELL WATER TO BE USED AS: 5 Public water supply 8 Air conditioning 11 Injection well

1 Domestic 3 Feedlot 6 Oil field water supply 9 Dewatering 12 Other (Specify below)

2 Irrigation 4 Industrial 7 Lawn and garden only 10 Monitoring wellWas a chemical/bacteriological sample submitted to Department? Yes X No If yes, mo/day/yr sample was submitted NAWater Well Disinfected? Yes No X

5 TYPE OF BLANK CASING USED:	5 Wrought iron	8 Concrete tile	CASING JOINTS: Glued Clamped
------------------------------	----------------	-----------------	--

1 Steel 3 RMP (SR) 6 Asbestos-Cement 9 Other (specify below) Welded

PVC 4 ABS 7 Fiberglass Threaded XBlank casing diameter 2 in. to 20 ft. Dia. in. to ft. Dia. in. to ft.Casing height above land surface 0 in. weight 7.16 lbs./ft. Wall thickness or gauge No. SCH 40 .154TYPE OF SCREEN OR PERFORATION MATERIAL: 7 PVC 10 Asbestos-cement

1 Steel 3 Stainless steel 5 Fiberglass 8 RMP (SR) 11 Other (specify)

2 Brass 4 Galvanized steel 6 Concrete tile 9 ABS 12 None used (open hole)

SCREEN OR PERFORATION OPENINGS ARE: 5 Gauzed wrapped 6 Saw cut 11 None (open hole)

1 Continuous slot 3 Mill slot 6 Wire wrapped 9 Drilled holes

2 Louvered shutter 4 Key punched 7 Torch cut 10 Other (specify)

SCREEN-PERFORATED INTERVALS: From 40' ft. to 20' ft. From ft. to ft.

From ft. to ft. From ft. to ft.

GRAVEL PACK INTERVALS: From 40' ft. to 18' ft. From ft. to ft.

From ft. to ft. From ft. to ft.

6 GROUT MATERIAL:	1 Neat cement	<u>Cement grout</u>	<u>Bentonite</u>	4 Other
-------------------	---------------	---------------------	------------------	---------

Grout Intervals: From 18 ft. to 2 ft. From 2 ft. to 0 ft. From ft. to ft.

What is the nearest source of possible contamination: 10 Livestock pens 14 Abandoned water well

1 Septic tank 4 Lateral lines 7 Pit privy 1 Fuel storage 15 Oil well/Gas well

2 Sewer lines 5 Cess pool 8 Sewage lagoon 12 Fertilizer storage 16 Other (specify below)

3 Watertight sewer lines 6 Seepage pit 9 Feedyard 13 Insecticide storage

Direction from well? How many feet? NA

FROM	TO	LITHOLOGIC LOG	FROM	TO	PLUGGING INTERVALS
------	----	----------------	------	----	--------------------

0 5 SILT-Black-soft5 15 SILT-BROWN15 23 SILT-DARK GRAY23 40 SILT-BROWN

7 CONTRACTOR'S OR LANDOWNER'S CERTIFICATION: This water well was (1) <u>constructed</u> , (2) reconstructed, or (3) plugged under my jurisdiction and was completed on (mo/day/year) <u>6-30-98</u> and this record is true to the best of my knowledge and belief. Kansas
--

Water Well Contractor's License No. 554 This Water Well Record was completed on (mo/day/yr) 8-3-98under the business name of Wootter Pump & Well, Inc by (signature) Wayne Wootter