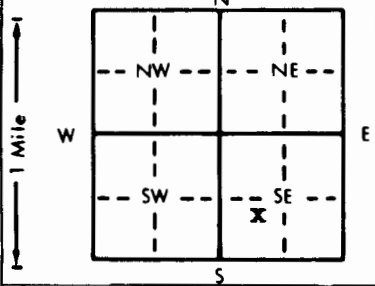


| | | | | | |
|---|-----------|--|-----------------------------|----------------------------------|--------------------------------|
| 1 LOCATION OF WATER WELL: County: SALINE | | Fraction NE 1/4 SW 1/4 SE 1/4 | Section Number 36 | Township Number T 14 S | Range Number R 3 E/W |
| Distance and direction from nearest town or city street address of well if located within city? 926 E. NEAL | | | | | |
| 2 WATER WELL OWNER: DWIGHT GAGE RR#, St. Address, Box #: 926 E. NEAL City, State, ZIP Code: SALINA, KS. 67401 Board of Agriculture, Division of Water Resources Application Number: | | | | | |
| 3 LOCATE WELL'S LOCATION WITH AN "X" IN SECTION BOX: <div style="text-align: center;"></div> | | 4 DEPTH OF COMPLETED WELL: 17 53.6 ft. ELEVATION: 1241 Depth(s) Groundwater Encountered 1. 43 ft. 2. ft. 3. ft. WELL'S STATIC WATER LEVEL 17 ft. below land surface measured on mo/day/yr 5-4-98 Pump test data: Well water was 18.5 ft. after 3 hours pumping 17 gpm Est. Yield 75+ gpm: Well water was ft. after hours pumping gpm Bore Hole Diameter 9 in. to 54 ft., and in. to ft. WELL WATER TO BE USED AS: 5 Public water supply 8 Air conditioning 11 Injection well 1 Domestic 3 Feedlot 6 Oil field water supply 9 Dewatering 12 Other (Specify below) 2 Irrigation 4 Industrial <u>7 Lawn and garden only</u> 10 Monitoring well Was a chemical/bacteriological sample submitted to Department? Yes No X ; If yes, mo/day/yr sample was submitted Water Well Disinfected? Yes X No | | | |
| 5 TYPE OF BLANK CASING USED: 1 Steel 3 RMP (SR) 5 Wrought iron 8 Concrete tile CASING JOINTS: Glued X Clamped 2 PVC 4 ABS 6 Asbestos-Cement 9 Other (specify below) Welded 7 Fiberglass Threaded Blank casing diameter 5 in. to 47.6 ft., Dia. in. to ft., Dia. in. to SDR 26 ft. Casing height above land surface 14 in., weight 160 lbs./ft. Wall thickness or gauge No. TYPE OF SCREEN OR PERFORATION MATERIAL: <u>7 PVC</u> 10 Asbestos-cement 1 Steel 3 Stainless steel 5 Fiberglass 8 RMP (SR) 11 Other (specify) 2 Brass 4 Galvanized steel 6 Concrete tile 9 ABS 12 None used (open hole) SCREEN OR PERFORATION OPENINGS ARE: 1 Continuous slot 3 Mill slot .035 - 5 Gauzed wrapped 8 Saw cut 11 None (open hole) 2 Louvered shutter 4 Key punched 7 Torch cut 9 Drilled holes 10 Other (specify) SCREEN-PERFORATED INTERVALS: From 47.6 ft. to 53.6 ft., From ft. to ft. From ft. to ft., From ft. to ft. GRAVEL PACK INTERVALS: From 40 ft. to 53.6 ft., From ft. to ft. From ft. to ft., From ft. to ft. | | | | | |
| 6 GROUT MATERIAL: 1 Neat cement 2 Cement grout <u>3 Bentonite</u> 4 Other Grout Intervals: From 0 ft. to 23 ft., From ft. to ft., From ft. to ft. What is the nearest source of possible contamination: 1 Septic tank 4 Lateral lines 7 Pit privy 10 Livestock pens 14 Abandoned water well 2 Sewer lines 5 Cess pool 8 Sewage lagoon 11 Fuel storage 15 Oil well/Gas well 3 Watertight sewer lines 6 Seepage pit 9 Feedyard 12 Fertilizer storage 16 Other (specify below) 13 Insecticide storage Direction from well? NORTH How many feet? 50 | | | | | |
| FROM | TO | LITHOLOGIC LOG | FROM | TO | PLUGGING INTERVALS |
| 0 | 3 | FILL DIRT | | | |
| 3 | 43 | CLAY TAN TO LIGHT GREEN | | | |
| 43 | 54 | SAND FINE TO COARSE CLEAN | | | |
| 7 CONTRACTOR'S OR LANDOWNER'S CERTIFICATION: This water well was (1) constructed, (2) reconstructed, or (3) plugged under my jurisdiction and was completed on (mo/day/year) 5-4-98 and this record is true to the best of my knowledge and belief. Kansas Water Well Contractor's License No. 388 This Water Well Record was completed on (mo/day/yr) 5-4-98 under the business name of PESTINGER PUMP SERVICE by (signature) <i>Paul Pestinger</i> | | | | | |
| INSTRUCTIONS: Use typewriter or ball point pen. PLEASE PRESS FIRMLY and PRINT clearly. Please fill in blanks, underline or circle the correct answers. Send top three copies to Kansas Department of Health and Environment, Bureau of Water, Topeka, Kansas 66620-0001. Telephone: 913-296-5545. Send one to WATER WELL OWNER and retain one for your records. | | | | | |

OFFICE USE ONLY

T

R

EW

SEC.

1/4

1/4

1/4