

# WATER WELL PLUGGING RECORD Form WWC-5P

KSA 82a-1212

ID NO.

SVE-7

**1 LOCATION OF WATER WELL:** Fraction  $\frac{1}{4}$  SW  $\frac{1}{4}$  SW  $\frac{1}{4}$  SW  $\frac{1}{4}$  Section Number **4** Township Number T **14** S Range Number **3** ☐ E ☒ W  
County: **Saline**

Street/Rural Address of Well Location; if unknown, distance & direction from nearest town or intersection: If at owner's address, check here ☐ 1112 N. Halstead Rd.  
Salina, KS 67401


## Global Positioning Systems (GPS) information:

Latitude: **38.8579411** (in decimal degrees)  
Longitude: **-097.6648705** (in decimal degrees)  
Elevation:  
Horizontal Datum: ☐ WGS84, ☒ NAD83, ☐ NAD27  
Collection Method:

**2 WATER WELL OWNER:** Bunge North America  
RR#, St. Address, Box #: 1391 Timberlake Manor Parkway  
City, State ZIP Code: Chesterfield, MO 63017

☐ GPS unit (Make/Model):  
☒ Digital Map/Photo, ☐ Topographic Map, ☐ Land Survey  
Est. Accuracy: ☒ < 3 m, ☐ 3-5 m, ☐ 5-15 m, ☐ > 15 m

**3 MARK WELL'S LOCATION WITH AN "X" IN SECTION BOX:**

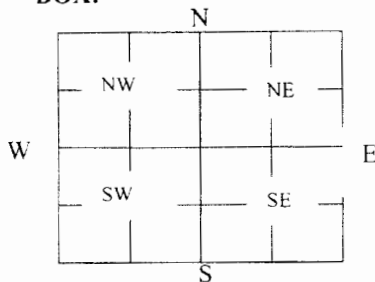

**4 DEPTH OF WELL** **18.36** ft.

WELL'S STATIC WATER LEVEL **8.61** ft

WELL WAS USED AS:

☐ Domestic ☐ Public Water Supply ☐ Dewatering  
☐ Irrigation ☐ Oil Field Water Supply ☐ Monitoring  
☐ Feedlot ☐ Domestic (Lawn & Garden) ☐ Injection Well  
☐ Industrial ☐ Air Conditioning ☒ Other Recov/Ext Well

Was a chemical/bacteriological sample submitted to Department? Yes ☐ No ☐

**5 TYPE OF BLANK CASING USED:**

☒ Steel ☐ RMP (SR) ☐ Wrought ☐ Fiberglass ☐ Other (Specify below)  
☒ PVC ☐ ABS ☐ Asbestos-Cement ☐ Concrete Tile

Blank casing diameter **4** in. Was casing pulled? Yes ☒ No ☐ If yes, how much **~3ft. below ground surface**  
Casing height above or below land surface \_\_\_\_\_ in.

**6 GROUT PLUG MATERIAL:** ☐ Neat cement ☐ Cement grout ☒ Bentonite ☐ Other \_\_\_\_\_

Grout Plug Intervals: From **3** ft. to **18.36** ft., From \_\_\_\_\_ ft. to \_\_\_\_\_ ft., From \_\_\_\_\_ ft. to \_\_\_\_\_ ft.

What is the nearest source of possible contamination:

☐ Septic tank ☐ Seepage pit ☐ Fuel storage ☐ Other (specify below)  
☐ Sewer lines ☐ Pit privy ☐ Fertilizer storage  
☐ Watertight sewer lines ☐ Sewage lagoon ☐ Insecticide storage  
☐ Lateral lines ☐ Feedyard ☐ Abandoned water well Direction from well? \_\_\_\_\_  
☐ Cess pool ☐ Livestock pens ☐ Oil well/Gas well How many feet? \_\_\_\_\_

FROM	TO	PLUGGING MATERIALS	FROM	TO	PLUGGING MATERIALS
3	18.36	Bentonite			

**7 CONTRACTOR'S OR LANDOWNER'S CERTIFICATION:** This water well was plugged under my jurisdiction and was completed on (mo/day/year) **06/06/2018** and this record is true to the best of my knowledge and belief. Kansas Water Well Contractor's License No. **N/A**. This Water Well Record was completed on (mo/day/year) **06/26/2018** under the business name of **GreenField Contractors, Inc.** by (signature) Melise D. McElwaine

Send one white copy to Kansas Department of Health & Environment, Geology Section, 1000 SW Jackson Street, Ste. 420, Topeka, KS 66612-1367. Send one copy to WATER WELL OWNER and retain one for your records.

Visit us at <http://www.kdheks.gov/waterwell/index.html> Telephone 785-296-5524.

KSA82a-1212

Revised 1/20/2015